

BOARD OF WATER COMMISSIONERS

CHOC
H 11
10-9-63

WATER WELL DRILLERS LOG **CODED**

Date: 10-9, 1963, Driller: MERRITT DRILLING CO County: Choctaw ~~Oktaha~~

(Name)

(1) Owner of Land: Roy Young
(Name)

ACKERMAN, MISS
(Address)

(2) Location: 19 17 14 S6c. 12 R.

6 miles EAST of Ackerman
(distance) (direction) (Nearest Town)

(3) Topography: FLAT
(Hilly) (Flat) (Level)

(4) Purpose of Well: DOMESTIC
(Domestic Irrigation
Municipal, Industrial, Other)

Description & Color of Materials
Sand, Clay, Red Clay, Shell, etc.

Thick-
ness
Feet

Depth
Feet

Red clay 0 12
yellow sand 15 30
white sand 30 50

Information upon completion of well:

(1) Diameter 2 inches.

(2) Total Depth 54 feet.

(3) Water Level 15 feet below top of ground.

(4) Cased to 40, Size 2


(5) Screen: Size 2, Length 5

(6) Were any formations sealed against pollution?
_____ yes, _____ no.

If YES depth of formation _____

Why _____

Drillers Remarks: _____

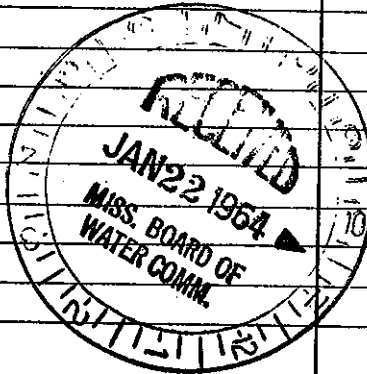

Well No. _____

(Use Back Side)

Mail this copy to Board of Water Commissioners 429 Miss. St. Jackson, Miss.