

CHOCTAW MISSISSIPPI BOARD OF WATER COMMISSIONERS

H12  
11-3-60

WATER WELL DRILLERS LOG

6-301  
CODED


Date: 11/31, 1960, Driller: L. K. Merritt County Choctaw  
(Name)

(1) Owner of Land: L. Robinson  
(Name)  
Ackerman, Miss.  
(Address)  
30 17 11  
(2) Location: 1/4, 1/4, Sec. T R  
2 1/2 miles N/W, of Ackerman,  
(distance) (direction) (Nearest Town)  
(3) Topography:  (Hilly)  (Flat)  (Level)  
(4) Purpose of Well: Domestic  
(Domestic Irrigation  
Municipal, Industrial, Other)

Description & Color of Materials Sand, Clay, Red Clay, Shell, etc.	Thick- ness Feet	Depth Feet
Red clay & sand	0	8
6" Hard Rock	8	22
Med. Hard White Clay	8	22
Soft White Clay	7	
Trace of blue sand	22	38
Hard Light Blue	38	44
Med. Soft blue Clay	44	58
Hard Green Clay	58	64
Soft blue clay	64	66
Hard blue Clay	66	72
Med. soft blue Clay	72	92
4" Rock at 92'	92	103
Soft blue Clay & shale		
2" Rock at 103	<del>103</del>	<del>125</del>
Soft Clay & shale	103	125
Trace of blue sand		
2" Rock at 116'		
Shale, fine blue	125	167
Sand, Trace of clay		

Information upon completion of well:

(1) Diameter: 2 inches.  
(2) Total Depth: 167 feet.  
(3) Water Level: 59 feet below top of ground.  
(4) Cased to 71, Size 2  
(5) Screen: Size open, Length \_\_\_\_\_  
(6) Were any formations sealed against pollution?  
 yes, \_\_\_\_\_ no.  
If YES depth of formation 2 shale traps  
Why at 71'

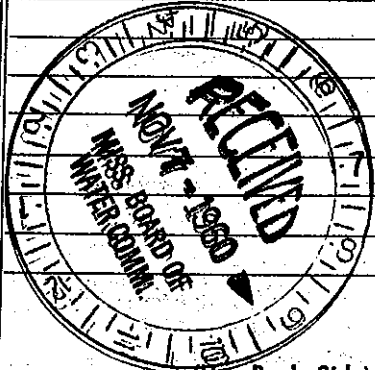

Well No.

Mail this copy to Board of Water Commissioners 429 Miss. St. Jackson, Miss.