

CHOCTAW

MISSISSIPPI BOARD OF WATER COMMISSIONERS

15

H13 WATER WELL DRILLERS LOG

8-28-63

Date: 8-28, 1963, Driller: MERRITT DRILLING CO County, Choctaw

CODED

(Name)

(1) Owner of Land:	Description & Color of Materials Sand, Clay, Red Clay, Shell, etc.	Thick- ness Feet	Depth Feet
V.F.W. (Name) ACKERMAN	Red clay & sand	0	2
24 17 N (Address)	White sand	2	75
(2) Location: 1/4, 1/4, Sec. T. R.	TAN SAND -	75	85
2 miles N.W. of ACKERMAN (distance) (direction) (Nearest Town)			
(3) Topography: HILLY (Hilly) (Flat) (Level)			
(4) Purpose of Well: DOMESTIC (Domestic Irrigation Municipal, Industrial, Other)			


Information upon completion of well:

- (1) Diameter 2 inches.
- (2) Total Depth 85 feet.
- (3) Water Level 58 feet below top of ground.
- (4) Cased to 78, Size 2
- (5) Screen: Size 1 1/4, Length 6'
- (6) Were any formations sealed against pollution?
_____ yes, _____ no.

If YES depth of formation _____

Why _____

Drillers Remarks: _____

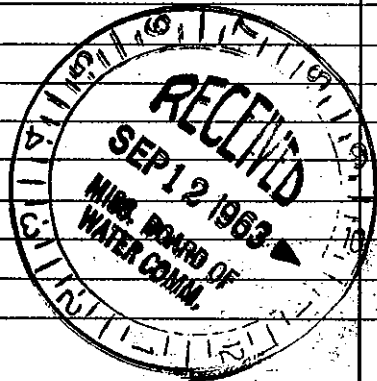

(Use Back Side)

Well No.

Mail this copy to Board of Water Commissioners 429 Miss. St. Jackson, Miss