


CHOCTAW MISSISSIPPI BOARD OF WATER COMMISSIONERS CODED

~~10-5-65~~ H 14  
10-5-65

WATER WELL DRILLERS LOG

Date 10-5- 1965, Driller: Merritt Drilling Co County CHOCTAW  
(Name)

(1) Owner of Land: <u>DAN KING</u> (Name)	Description & Color of Materials Sand, Clay, Red Clay, Shell, etc.	Thick- ness Feet	Depth Feet
<u>Ackerman, Miss.</u> (Address)	<u>Red sand &amp; clay</u>	<u>0</u>	<u>12</u>
(2) Location: <u>1/4</u> , <u>19.17</u> <u>11</u> <u>R</u>	<u>Blue sand &amp; clay</u>	<u>12</u>	<u>55</u>
<u>3</u> miles <u>S. W</u> , of <u>Ackerman</u> (distance) (direction) (Nearest Town)	<u>FINE WHITE SANDS</u>	<u>55</u>	<u>67</u>
(3) Topography: <u>Hilly</u> (Hilly) (Flat) (Level)	<u>LIGNITE</u>	<u>67</u>	<u>80</u>
(4) Purpose of Well: <u>Domestic</u> (Domestic Irrigation Municipal, Industrial, Other)	<u>SOFT GREEN CLAY</u>	<u>80</u>	<u>102</u>
Information upon completion of well:	<u>Trace of Blue sand</u>	<u>102</u>	<u>105</u>
(1) Diameter <u>2</u> inches.	<u>HARD Blue clay</u>	<u>105</u>	<u>137</u>
(2) Total Depth <u>297</u> feet.	<u>Blue sand</u>	<u>137</u>	<u>147</u>
(3) Water Level <u>80'</u> feet below top of ground.	<u>HARD Blue clay</u>	<u>147</u>	<u>168</u>
(4) Cased to <u>189'</u> , Size <u>2"</u>	<u>ROCK</u>	<u>168</u>	<u>189</u>
(5) Screen: Size <u>OPEN</u> , Length _____	<u>Blue Gumbo</u>	<u>168</u>	<u>189</u>
(6) Were any formations sealed against pollution? ____ yes, ____ no.	<u>Blue clay</u>	<u>189</u>	<u>200</u>
If YES depth of formation _____	<u>LIGNITE</u>	<u>200</u>	<u>205</u>
Why _____	<u>Blue clay</u>	<u>205</u>	<u>231</u>
Drillers Remarks: _____	<u>Mixed Green sand &amp; clay</u>	<u>231</u>	<u>297</u>

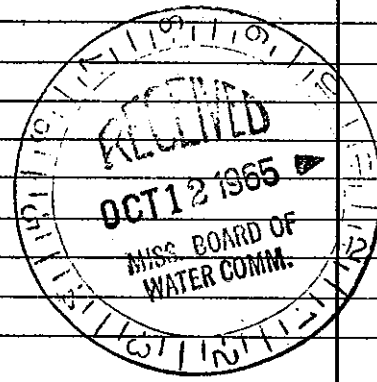

Well No.

(Use Back Side)

Mail this copy to Board of Water Commissioners 429 Miss. St. Jackson, Mis: