

Choctaw MISSISSIPPI BOARD OF WATER COMMISSIONERS

H 15  
7/64 00730

WATER WELL DRILLERS LOG

Date: 7-24-1964, Driller: Layne-Central Co. (Name)


**CODED**

(1) Owner of Land:	Description & Color of Materials Sand, Clay, Red Clay, Shell, etc.	Thick- ness Feet	Depth Feet
Town of Ackerman (Name)	top soil	2	2
Ackerman, Mississippi (Address)	brown clay	10	14
(2) Location: 1/4, 30 17 11, Sec. T R	blue clay-sand stks	10	24
miles, of (distance) (direction) (Nearest Town)	sand	88	112
(3) Topography: (Hilly) (Flat) (Level)			
(4) Purpose of Well: municipal (Domestic Irrigation Municipal, Industrial, Other)			

Information upon completion of well:

- (1) Diameter 20 inches.
- (2) Total Depth 112 feet.
- (3) Water Level 5' feet below top of ground.
- (4) Cased to 82', Size 12"
- (5) Screen: Size 8", Length 40'
- (6) Were any formations sealed against pollution?  
 yes,  no.  
 If YES depth of formation 82'  
 Why required
- Drillers Remarks:

**CODED**

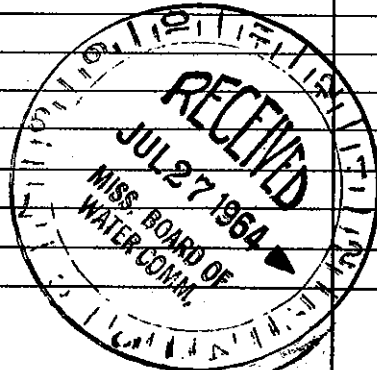

Well No.

(Use Back Side)

Mail this copy to Board of Water Commissioners 429 Miss. St. Jackson, Miss.