

CHOCTAW MISSISSIPPI BOARD OF WATER COMMISSIONERS

H 18

10-22-65

WATER WELL DRILLERS LOG

CODED

Date: 10-22, 1965, Driller: Merritt Drilling Co. County: Choctaw
(Name)

(1) Owner of Land: Billy Hill
(Name)
Rfd. Ackerman
(Address)
9 17 11

(2) Location: 3 miles South of Ackerman
(distance) (direction) (Nearest Town)

(3) Topography: Hilly
(Hilly) (Flat) (Level)

(4) Purpose of Well: Domestic
(Domestic Irrigation
Municipal, Industrial, Other)

Description & Color of Materials Sand, Clay, Red Clay, Shell, etc.	Thick- ness Feet	Depth Feet
Red Clay	0	10
Blue clay	10	16
LIGNITE	16	20
Rock	20	20 1/2
Green clay	20 1/2	34
20 Rock	24	24 1/2
GREEN CLAY	24 1/2	26
SAND ROCK	26	31
Blue clay & sand	31	45
Rock -	45	46
Green clay	46	61
LIGNITE	61	64
Green clay	64	69
Green clay & sand	69	78
Blue sand	78	100

Information upon completion of well:

(1) Diameter 2 inches.

(2) Total Depth 100 feet.

(3) Water Level 40 feet below top of ground.

(4) Cased to 63, Size 2


(5) Screen: Size open, Length _____.

(6) Were any formations sealed against pollution?
_____ yes, _____ no.

If YES depth of formation _____

Why _____

Drillers Remarks: Shale trap
Set. At 63'

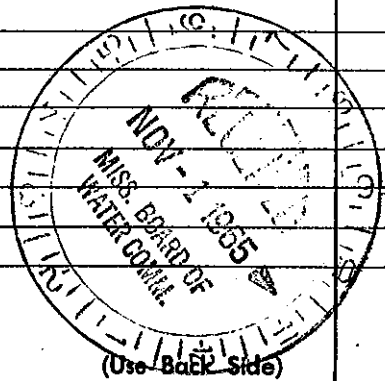

Well No.

Mail this copy to Board of Water Commissioners 429 Miss. St. Jackson, Mis: