

CHOCTAW MISSISSIPPI BOARD OF WATER COMMISSIONERS

H 21

4-30-66

WATER WELL DRILLERS LOG

CODED

Date: 4-30, 1966, Driller: MERRITT Dilling County, CHOCTAW
(Name)


(1) Owner of Land: <u>Roy Dobbs</u> (Name)	Description & Color of Materials Sand, Clay, Red Clay, Shell, etc.	Thick- ness Feet	Depth Feet
<u>Ackerman, Miss</u> (Address)			
(2) Location: <u>1/4</u> , <u>1/4</u> , Sec. <u>T</u> <u>R</u>	<u>Red Clay</u>	<u>0</u>	<u>10</u>
<u>2</u> miles <u>NORTH</u> , of <u>Ackerman</u> (distance) (direction) (Nearest Town)	<u>FINE WHITE SAND</u>	<u>10</u>	<u>21</u>
(3) Topography: <u>Hilly</u> (Hilly) (Flat) (Level)	<u>+ CLAY</u>		
(4) Purpose of Well: <u>DOMESTIC</u> (Domestic Irrigation Municipal, Industrial, Other)	<u>FINE RED SAND</u>	<u>21</u>	<u>35</u>
	<u>VERY FINE BLUE SAND</u>		
	<u>+ CLAY</u>	<u>35</u>	<u>41</u>
	<u>TAN SAND VERY FINE</u>	<u>41</u>	<u>65</u>
	<u>BLUE SAND</u>	<u>65</u>	<u>67</u>
	<u>FINE WHITE SAND MIXED</u>		
	<u>WITH SAND ROCK</u>	<u>67</u>	<u>75</u>
	<u>BLUE CLAY + SAND</u>	<u>75</u>	<u>105</u>
	<u>HARD BLUE SAND +</u>		
	<u>GRAVEL</u>	<u>105</u>	<u>150</u>

Information upon completion of well:

- (1) Diameter 2 inches.
- (2) Total Depth 150 feet.
- (3) Water Level 30 feet below top of ground.
- (4) Cased to 86, Size _____.
- (5) Screen: Size open, Length _____.
- (6) Were any formations sealed against pollution?
 yes, _____ no.

If YES depth of formation Shale Trap
AT-84-PT1
Why _____

Drillers Remarks: _____

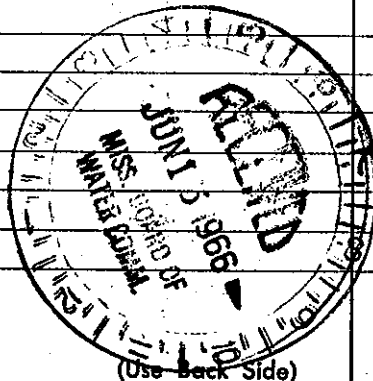

Well No. _____

Mail this copy to Board of Water Commissioners 429 Miss. St. Jackson, Miss.