

CHOCTAW MISSISSIPPI BOARD OF WATER COMMISSIONERS

H22

5-2-66

WATER WELL DRILLERS LOG

CODED

Date: 5-2, 1966, Driller: Merritt Drilling Co. County Choctaw
 (Name)

(1) Owner of Land: <u>MORRIS O'BANNON</u> <small>(Name)</small> <u>ACKERMAN, Miss.</u> <small>(Address)</small>	Description & Color of Materials Sand, Clay, Red Clay, Shell, etc.	Thick- ness Feet	Depth Feet
(2) Location: <u>18 17 11</u> <small>1/4, 1/4, Sec. T R</small> <u>2</u> miles <u>NORTH</u> of <u>ACKERMAN</u> <small>(distance) (direction) (Nearest Town)</small>	<u>Red clay</u>	<u>0</u>	<u>6</u>
(3) Topography: <u>Hilly</u> <small>(Hilly) (Flat) (Level)</small>	<u>Blue clay</u>	<u>6</u>	<u>26</u>
(4) Purpose of Well: <u>DOMESTIC</u> <small>(Domestic Irrigation Municipal, Industrial, Other)</small>	<u>FINE BLUE SAND</u>	<u>26</u>	<u>60</u>
	<u>Blue sand + shale</u>	<u>60</u>	<u>105</u>


Information upon completion of well:

- (1) Diameter 2 inches.
- (2) Total Depth 105 feet.
- (3) Water Level 27 feet below top of ground.
- (4) Cased to 63, Size 2
- (5) Screen: Size 2, Length 6
- (6) Were any formations sealed against pollution?
 yes, no.

If YES depth of formation _____

Why _____

Drillers Remarks: _____

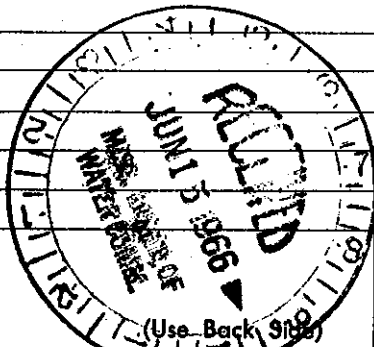

Well No. _____

Mail this copy to Board of Water Commissioners 429 Miss. St. Jackson, Miss