

MISSISSIPPI BOARD OF WATER COMMISSIONERS

#2

WATER WELL DRILLERS LOG


9-15, 1966, Driller: Smith Forge welding County Choctaw
 (When well drilled) (Name) (Where well is located)

Owner of Land: E. D. Schellinger
 (Name)
Box 13A McCoal Miss.
 (Address)
 Location: N 3/4 1/4, SE 1/4, Sec. 32 T16R10E
4 miles SE of McCoal
 (distance) (direction) (Nearest Town)
 Topography: hilly (Level)
 (Hilly) (Flat)
 Purpose of Well: domestic
 (Domestic Irrigation, Municipal, Industrial, Other)

Description & Color of Materials Sand, Clay, Red Clay, Shell, etc.	Thick- ness Feet	Depth Feet
<u>gray silt sand</u>	<u>2</u>	<u>302</u>
<u>gray clay</u>	<u>15</u>	<u>317</u>
<u>gray rock</u>	<u>3</u>	<u>320</u>
<u>blue clay</u>	<u>30</u>	<u>350</u>
<u>black clay</u>	<u>10</u>	<u>360</u>

Information upon completion of well:

- (1) Diameter 2 inches.
- (2) Total Depth 360 feet.
- (3) Water Level 65 feet below top of ground.
- (4) Cased to 210, Size 2
- (5) Screen: Size X, Length X
- (6) Were any formations sealed against pollution?
X yes, X no.
 If YES depth of formation _____

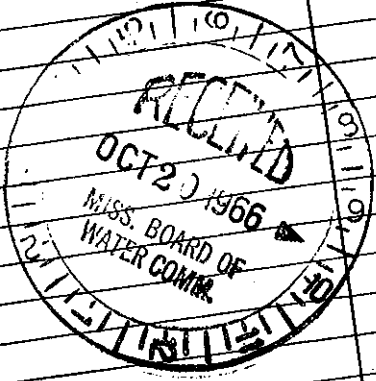

Why _____
 Drillers Remarks: open well
 Yield in gpm: flow water good
 Size pump: enough to tap
 Type power: hand screens

Mail this copy to Board of Water Commissioners 429 Miss. St. Jackson, Miss.