

CHOCTAW

MISSISSIPPI BOARD OF WATER COMMISSIONERS

J 13

2-15-63

WATER WELL DRILLERS LOG

CODED

Date: Feb 15, 1963, Driller: J. L. Merritt County Choctaw

(Name)

(1) Owner of Land:	Description & Color of Materials Sand, Clay, Red Clay, Shell, etc.	Thick- ness Feet	Depth Feet
Robert W. Lacey (Name)	Red CLAY	0	12
Weir Miss (Address)	tan SAND.	12	48
(2) Location: 1/4, 20 16 10, Sec. T R	WHITE SAND.	48	84
_____ miles _____ of Weir (distance) (direction) (Nearest Town)			
(3) Topography: _____ (Hilly) (Flat) (Level)			
(4) Purpose of Well: _____ (Domestic Irrigation Municipal, Industrial, Other)			

Information upon completion of well:


CODED

- (1) Diameter 2" inches.
- (2) Total Depth 87 feet.
- (3) Water Level _____ feet below top of ground.
- (4) Cased to 84, Size 2"
- (5) Screen: Size 1 1/4", Length 6 ft.
- (6) Were any formations sealed against pollution?
_____ yes, no.

If YES depth of formation _____

Why _____

Drillers Remarks: _____

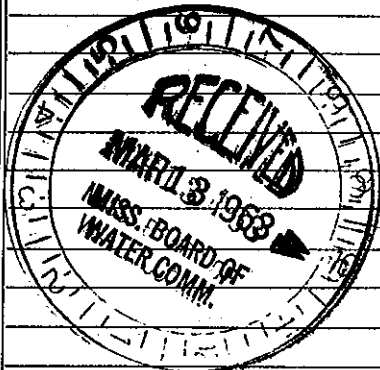

Well No. _____

(Use Back Side)

Mail this copy to Board of Water Commissioners 429 Miss. St. Jackson, Miss