

CHOCTAW MISSISSIPPI BOARD OF WATER COMMISSIONERS

~~7-15-60~~ J14

WATER WELL DRILLERS LOG

CODED

Date: 7-15-60, 1960, Driller: E. K. Merritt County Choctaw  
(Name)

		Description & Color of Materials Sand, Clay, Red Clay, Shell, etc.	Thick- ness Feet	Depth Feet
(1) Owner of Land: <u>Mrs. M. Smith</u> (Name)		<u>Red surface sand</u>	<u>0</u>	<u>16</u>
<u>Rt 2 ACKERMAN, Miss</u> (Address)		<u>yellow clay, trace</u>	<u>16</u>	<u>38</u>
(2) Location: <u>1/4</u> , <u>16 19 10</u> , Sec. <u>T</u> <u>R</u>		<u>hard lignite (hard)</u>	<u>38</u>	<u>40</u>
<u>8</u> miles <u>South</u> of <u>ENDORA</u> (distance) (direction) (Nearest Town)		<u>Med. hard sandstone</u>	<u>40</u>	<u>58</u>
(3) Topography: <input checked="" type="checkbox"/> (Hilly) <input type="checkbox"/> (Flat) <input type="checkbox"/> (Level)		<u>Lignite</u>	<u>58</u>	<u>59</u>
(4) Purpose of Well: <u>Domestic</u> (Domestic Irrigation Municipal, Industrial, Other)		<u>Med. hard sand rock</u>	<u>59</u>	<u>62</u>
		<u>Soft lignite</u>	<u>62</u>	<u>64</u>
		<u>Hard green clay</u>	<u>64</u>	<u>69</u>
		<u>Hard grey clay</u>	<u>69</u>	<u>93</u>
		<u>2" Rock at</u>	<u>89</u>	
		<u>Hard lignite</u>	<u>93</u>	<u>98</u>
		<u>Fine blue sand</u>		
		<u>+ mica</u>	<u>98</u>	<u>114</u>
		<u>Lignite</u>	<u>114</u>	<u>116</u>
		<u>Soft clay, trace of</u>	<u>116</u>	<u>147</u>
		<u>sand</u>		
		<u>Soft grey clay &amp; fine</u>	<u>147</u>	<u>169</u>
		<u>sand</u>		

Information upon completion of well:

(1) Diameter 2 inches.

(2) Total Depth 167 feet.

(3) Water Level 37 feet below top of ground.

(4) Cased to 96, Size 2


(5) Screen: Size OPEN, Length \_\_\_\_\_

(6) Were any formations sealed against pollution?  
 yes, \_\_\_\_\_ no.

If YES depth of formation 96'

Why To prevent sand &

Drillers Remarks pit from filling  
hole below bottom of  
casing

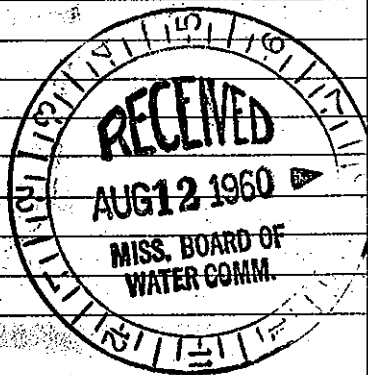

Well No.

(Use Back Side)

Mail this copy to Board of Water Commissioners 429 Miss. St. Jackson, Miss