

CHOCTAW MISSISSIPPI BOARD OF WATER COMMISSIONERS

~~4-5-61~~ J10  
4-5-61

WATER WELL DRILLERS LOG

CODE A 300

Date: 4/5/1961, Driller: E. K. MERRITT County: CHOCTAW WEBSTER


(1) Owner of Land: W. W. COOK  
(Name)  
R. 7th ENIDRA, MISS  
(Address)  
(2) Location: 8 1/4 Sec. 14 10 T. R.  
4 miles S. E. of ENIDRA  
(distance) (direction) (Nearest Town)  
(3) Topography:  (Hilly)  (Flat)  (Level)  
(4) Purpose of Well: DOMESTIC  
(Domestic Irrigation, Municipal, Industrial, Other)

Description & Color of Materials Sand, Clay, Red Clay, Shell, etc.	Thick- ness Feet	Depth Feet
Light grey clay	0	17
1/4" Rock at 17'		
Dark blue clay	17	26
Hard lignite	26	28
Hard light blue clay	28	39
Med. soft blue clay	39	52
Soft grey clay, trace of powder sand	52	76
Med. soft dark clay	76	104
Fine powder sand, Salt, trace of shale	104	127
Fine sand shell	127	201
Med. soft dark clay	201	202

Information upon completion of well:

(1) Diameter 2 inches.  
(2) Total Depth 202 feet.  
(3) Water Level 90 feet below top of ground.  
(4) Cased to 192, Size 2  
(5) Screen: Size 1/4", Length 6'  
(6) Were any formations sealed against pollution?  
 yes,  no.

If YES depth of formation 192 - Shale  
Why Troy  
Drillers Remarks: Shah Troy placed  
above screen to prevent  
Salt & Fine sand from  
Clogging screen.

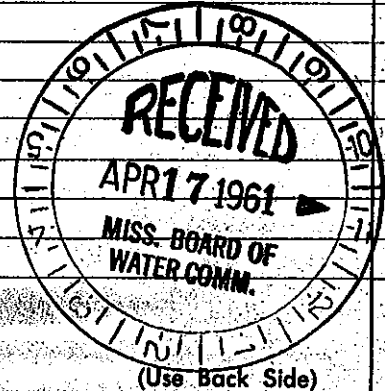

Well No.

Mail this copy to Board of Water Commissioners 429 Miss. St. Jackson, Miss.