

CHOCTAW MISSISSIPPI BOARD OF WATER COMMISSIONERS

J 17

10-22-63

WATER WELL DRILLERS LOG

CODED

Date: 10-25, 1963, Driller: MERRITT DALLING County: CHOCTAW

(Name)

(1) Owner of Land: TOWNSEND HUNT
(Name)

Description & Color of Materials
Sand, Clay, Red Clay, Shell, etc.

Thick-
ness
Feet

Depth
Feet

WEIR MISS

(Address)

Red clay
TAN SAND

0 10
10 60

(2) Location: 1/4, 13 16 10 Sec. T R

4 miles South of FENTRESS
(distance) (direction) (Nearest Town)

(3) Topography: Hilly
(Hilly) (Flat) (Level)

(4) Purpose of Well: DOMESTIC
(Domestic Irrigation
Municipal, Industrial, Other)

Information upon completion of well:

CODED

(1) Diameter 2 inches.

(2) Total Depth 60 feet.

(3) Water Level 30 feet below top of ground.

(4) Cased to 54, Size 2

(5) Screen: Size 1 1/4, Length 6'


(6) Were any formations sealed against pollution?

yes, no,

If YES depth of formation _____

Why _____

Drillers Remarks: _____

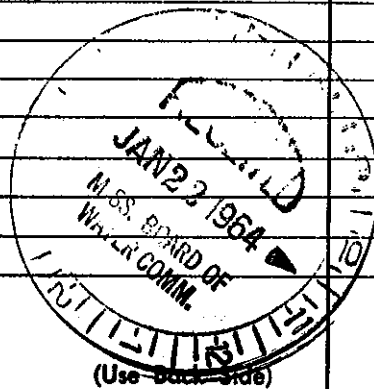

Well No. _____

Mail this copy to Board of Water Commissioners 429 Miss. St. Jackson, Miss.