

CHOCTAW MISSISSIPPI BOARD OF WATER COMMISSIONERS

J20
1-24-64

WATER WELL DRILLERS LOG

CODED

Date: 1-24, 1964, Driller: MERRITT DRILLING CO. County WINSTON
(Name)

(1) Owner of Land: <u>CLYDE MORGAN</u> (Name)	Description & Color of Materials Sand, Clay, Red Clay, Shell, etc.	Thick- ness Feet	Depth Feet
<u>WEIR MISS</u> (Address)	<u>Red clay</u>	<u>8</u>	<u>18</u>
(2) Location: <u>1/4</u> , <u>4 16 10</u> Sec. <u>T</u> <u>R</u>	<u>Yellow sand</u>	<u>18</u>	<u>26</u>
<u>2</u> miles <u>NORTH</u> , of <u>WEIR</u> (distance) (direction) (Nearest Town)	<u>PINK SAND.</u>	<u>26</u>	<u>42</u>
(3) Topography: <u>Hilly</u> (Hilly) (Flat) (Level)	<u>FINE WHITE SAND.</u>	<u>42</u>	<u>65</u>
(4) Purpose of Well: <u>DOMESTIC</u> (Domestic Irrigation Municipal, Industrial, Other)			

Information upon completion of well:

(1) Diameter 2 inches.

(2) Total Depth 65 feet.

(3) Water Level 42 feet below top of ground.

(4) Cased to 56, Size 2.


(5) Screen: Size 1 1/4, Length 6.

(6) Were any formations sealed against pollution?
yes, no.

If YES depth of formation _____

Why _____

Drillers Remarks: _____

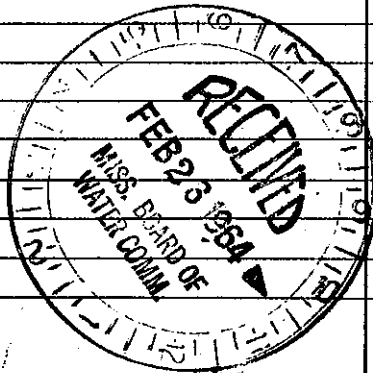

(Use Back Side)

Well No.

Mail this copy to Board of Water Commissioners 429 Miss. St. Jackson, Mis: