

CHOCTAW MISSISSIPPI BOARD OF WATER COMMISSIONERS

J 21


1-28-64

WATER WELL DRILLERS LOG

CODED

Date: 1-28, 1964, Driller: MERRITT DRILLING CO County WINSTON
(Name)

	Description & Color of Materials Sand, Clay, Red Clay, Shell, etc.	Thick- ness Feet	Depth Feet
(1) Owner of Land: <u>ROBERT LACY</u>	<u>Red clay</u>	<u>6</u>	<u>70</u>
(Name)			
<u>WVIA Miss.</u>	<u>yellow sand</u>	<u>10</u>	<u>72</u>
(Address)			
(2) Location: <u>1/4</u> , <u>20 16 10</u> Sec. <u>T</u> <u>R</u>			
<u>6</u> miles <u>South</u> , of <u>WVIA</u>			
(distance) (direction) (Nearest Town)			
(3) Topography: <u>Hilly</u>			
(Hilly) (Flat) (Level)			
(4) Purpose of Well: <u>DOMESTIC</u>			
(Domestic Irrigation Municipal, Industrial, Other)			
Information upon completion of well:			
(1) Diameter <u>2</u> inches.			
(2) Total Depth <u>72</u> feet.			
(3) Water Level <u>30</u> feet below top of ground.			
(4) Cased to <u>63</u> , Size <u>2</u>			
(5) Screen: Size <u>1 1/4</u> , Length <u>6'</u>			
(6) Were any formations sealed against pollution?			
_____ yes, <input checked="" type="checkbox"/> no.			
If YES depth of formation _____			
Why _____			
Drillers Remarks: _____			

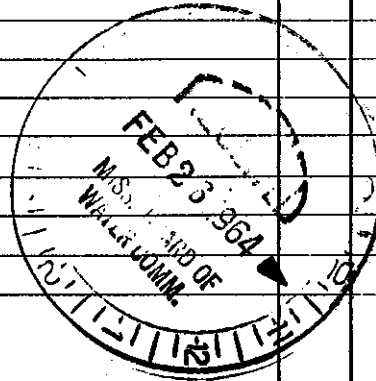

Well No.

(Use Back Side)

Mail this copy to Board of Water Commissioners 429 Miss. St. Jackson, Miss.