

**CHOCTAW MISSISSIPPI BOARD OF WATER COMMISSIONERS**

**J23**

**8-2-65**

**WATER WELL DRILLERS LOG**

Date: 8-2, 1965, Driller: MERRITT DRILLING County CHOCTAW


(Name) **CODED**

(1) Owner of Land: <u>T. Mitchell</u> (Name)	Description & Color of Materials Sand, Clay, Red Clay, Shell, etc.	Thick- ness Feet	Depth Feet
<u>RT. 1 - Tompoken, Miss</u> (Address)	<u>TOP SOIL</u>	<u>0</u>	<u>2</u>
(2) Location: <u>8 16 10</u> <u>7 miles south of Tompoken</u> (distance) (direction) (Nearest Town)	<u>Red clay</u>	<u>2</u>	<u>10</u>
(3) Topography: <u>Hilly</u> (Hilly) (Flat) (Level)	<u>Red sand</u>	<u>10</u>	<u>20</u>
(4) Purpose of Well: <u>Domestic</u> (Domestic Irrigation Municipal, Industrial, Other)	<u>TAN SAND &amp; CLAY</u>	<u>20</u>	<u>80</u>
	<u>WHITE SAND</u>	<u>80</u>	<u>126</u>

**Information upon completion of well:**

- (1) Diameter 2 inches.
- (2) Total Depth 126 feet.
- (3) Water Level 50 feet below top of ground.
- (4) Cased to 120, Size 3"
- (5) Screen: Size 1/4", Length 6'
- (6) Were any formations sealed against pollution?  
no

**CODED**

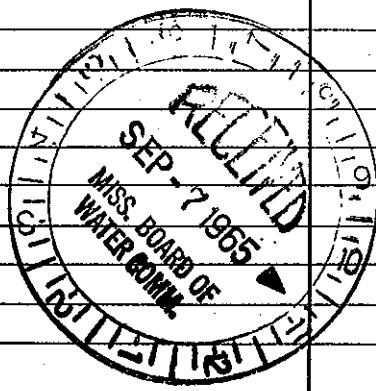

Well No.

(Use Back Side)

Mail this copy to Board of Water Commissioners 429 Miss. St. Jackson, Miss.