

**CHOCTAW MISSISSIPPI BOARD OF WATER COMMISSIONERS**

**J 25**

**WATER WELL DRILLERS LOG**

**10-12-65**

Date: Oct. 12, 1965, Driller: Merritt Drilling Co. County Choctaw  
(Name)

(1) Owner of Land: <u>Elmer Winters</u> (Name)	Description & Color of Materials Sand, Clay, Red Clay, Shell, etc.	Thick- ness Feet	Depth Feet
<u>Rt. 1, Weir - Miss</u> (Address)	<u>Red Clay</u>	<u>0</u>	<u>12</u>
(2) Location: <u>22 16 10</u> <u>5</u> miles <u>South</u> , of <u>Weir</u> (distance) (direction) (Nearest Town)	<u>Red Sand</u>	<u>12</u>	<u>20</u>
(3) Topography: <u>Hilly</u> (Hilly) (Flat) (Level)	<u>White Sand</u>	<u>20</u>	<u>75</u>
(4) Purpose of Well: <u>DOMESTIC</u> (Domestic Irrigation Municipal, Industrial, Other)			

Information upon completion of well:

(1) Diameter 2 inches.

(2) Total Depth 78 feet.

(3) Water Level 48 feet below top of ground.

(4) Cased to 63, Size 2


(5) Screen: Size 2, Length 5

(6) Were any formations sealed against pollution?  
yes,  yes,  no.

If YES depth of formation \_\_\_\_\_

Why \_\_\_\_\_

Drillers Remarks: \_\_\_\_\_

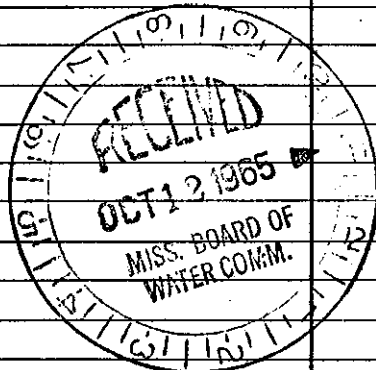

Well No.

(Use Back Side)

Mail this copy to Board of Water Commissioners 429 Miss. St. Jackson, Miss.