

Choctaw

#1

F 26 MISSISSIPPI BOARD OF WATER COMMISSIONERS

9-66

WATER WELL DRILLERS LOG CODE 11

Date: 9-15, 1966, Driller: Smith Forge & Welding County Choctaw

(When well drilled)

(Name)

(Where well is located)

(1) Owner of Land:	Description & Color of Materials	Thick-ness Feet	Depth Feet
Mr. E. F. Nicholls Jr. (Name)	Red clay	19	99
Rt. B. 13A McCool miss. (Address)	red sand	10	109
	red clay	14	123
(2) Location: SW 1/4, SE 1/4, Sec. 32-76R10E	red clay sand	11	134
4 miles SE of McCool (distance) (direction) (Nearest Town)	mixture		
	white clay red		
(3) Topography: Hilly (Hilly) (Flat) (Level)	sand mixture	18	152
	blue clay	8	160
(4) Purpose of Well: Domestic (Domestic Irrigation Municipal, Industrial, Other)	blue clay white		
	clay mixture	8 1/4	168 1/4
	fine red sand	8	176 1/4
	fine sand blue clay mix.	10	186 1/4
	fine sand	7	193 1/4
	blue clay	13	206 1/4
	rock	2	208 1/4
	sand	10	218 1/4
	sand blue clay nit.	8	226 1/4
	blue clay	22	248 1/4
	gray rock	3	251 1/4
	white clay sand char-	5	256 1/4
	coal mixture	5	261 1/4
	blue clay	14	275 1/4
	hard rock	2	277 1/4
	black silt sand	3	280 1/4
	blue clay	11	291 1/4
	gray silt	5	296 1/4
	rock	3	299 1/4
	gray silt	10	309 1/4
	gray clay	5	314 1/4
	gray silt sand	12	326 1/4
	white clay lignite		
	mixture	14 1/2	340 1/2
			20

Information upon completion of well:

- (1) Diameter 2 inches.
- (2) Total Depth 360 feet.
- (3) Water Level 65 feet below top of ground.
- (4) Cased to 210, Size 2"
- (5) Screen: Size X, Length X
- (6) Were any formations sealed against pollution?  
X yes, X no.

If YES depth of formation


Why

Drillers Remarks:

Yield in gpm:

Size pump:

Type power:

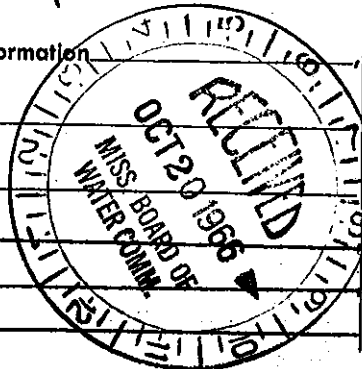

Mail this copy to Board of Water Commissioners 429 Miss. St. Jackson, Miss.