

CHOCTAW MISSISSIPPI BOARD OF WATER COMMISSIONERS

J28

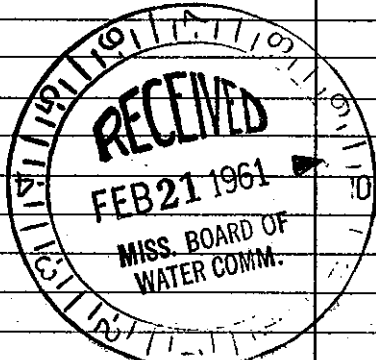
WATER WELL DRILLERS LOG

H or J

1-23-61

CODED

Date: 1/23/, 1961, Driller: F. K. MERRITT County CHOCTAW
(Name)

| (1) Owner of Land | Description & Color of Materials Sand, Clay, Red Clay, Shell, etc. | Thick- ness Feet | Depth Feet |
|--|---|------------------------|---------------|
| <u>T B HENSON</u> (Name) <u>Ackerman</u> <u>Miss</u> (Address) | <u>Surface Sand</u> | <u>0</u> | <u>20</u> |
| (2) Location: <u>1/4</u> , <u>1/4</u> , Sec. <u>11 16 10</u> T R | <u>Clay cut with sand</u> | <u>20</u> | <u>25</u> |
| <u>2</u> miles <u>SW</u> of <u>FENTRESS</u> (distance) (direction) (Nearest Town) | <u>Fine White Sand</u> | <u>25</u> | <u>45</u> |
| (3) Topography: <input checked="" type="checkbox"/> (Hilly) <input type="checkbox"/> (Flat) <input type="checkbox"/> (Level) | <u>Sand Rock at 45'</u> | | |
| (4) Purpose of Well: <u>DOMESTIC</u> (Domestic Irrigation Municipal, Industrial, Other) | | | |
| Information upon completion of well: | | | |
| (1) Diameter <u>2</u> inches. |  | | |
| (2) Total Depth <u>45</u> feet. | | | |
| (3) Water Level <u>31</u> feet below top of ground. | | | |
| (4) Cased to <u>38</u> , Size <u>2</u> | | | |
| (5) Screen: Size <u>1/4</u> , Length <u>6'</u> | | | |
| (6) Were any formations sealed against pollution? <u>no.</u> | | | |
| If YES depth of formation _____ | | | |
| Why _____ | | | |
| Drillers Remarks: _____ | | | |
| _____ | | | |
| _____ | | | |

(Use Back Side)

Well No.

Mail this copy to Board of Water Commissioners 429 Miss. St. Jackson, Miss.