

CHOCTAW

MISSISSIPPI BOARD OF WATER COMMISSIONERS

K 4


11-1-62

WATER WELL DRILLERS LOG

CODED
CODED

Date: 11-1, 1962 Driller: J. L. MERRITT County CHOCTAW

(1) Owner of Land:	Description & Color of Materials Sand, Clay, Red Clay, Shell, etc.	Thick- ness Feet	Depth Feet
LYMAN HURT (Name) MORRIS (Address)	Red. clay	0	25
(2) Location: 1/4, 1/4, Sec. T. R.	LIGNITE	25	30
4 miles South of Ackerman (distance) (direction) (Nearest Town)	Blue clay	30	70
(3) Topography: HILLY (Hilly) (Flat) (Level)	LIGNITE	90	10
(4) Purpose of Well: DOMESTIC (Domestic Irrigation Municipal, Industrial, Other)	GREEN CLAY	100	160
Information upon completion of well:	LIGNITE	160	170
(1) Diameter 2 inches.	GREEN CLAY	170	180
(2) Total Depth 235 feet.	WHITE CHALK	185	20
(3) Water Level 105 feet below top of ground.	Blue sand	20	23
(4) Cased to 168, Size 2	CODED		
(5) Screen: Size 4/8, Length			
(6) Were any formations sealed against pollution?			
yes, no.			
If YES depth of formation			
Why			
Drillers Remarks: Shale trap			
Set. 165'			

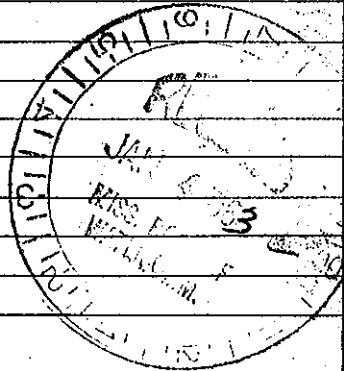

(Use Back Side)

Well No.

Mail this copy to Board of Water Commissioners 429 Miss. St. Jackson, Miss.