

CHOCTAW MISSISSIPPI BOARD OF WATER COMMISSIONERS

K⁵

1-15-65

WATER WELL DRILLERS LOG

Date: 1-15, 1965, Driller: Merritt Drilling Co County: CHOCTAW
(Name)

(1) Owner of Land: WILBUR CARR
(Name)
RT. 1 - ACKERMAN
(Address)

(2) Location: $\frac{1}{4}$, 27, $\frac{1}{4}$, Sec. 16 T 11 R
7 miles South, of ACKERMAN
(distance) (direction) (Nearest Town)

(3) Topography: Hilly
(Hilly) (Flat) (Level)

(4) Purpose of Well: DOMESTIC
(Domestic Irrigation, Municipal, Industrial, Other)

Description & Color of Materials Sand, Clay, Red Clay, Shell, etc.	Thick- ness Feet	Depth Feet
Red clay	0	11
White clay	11	30
Blue clay	30	42
Green clay	42	52
Grey clay	52	54
Green clay	54	57
Blue clay	57	60
Grey clay	60	118
Grey clay + sand	118	120
Grey clay	120	122
Grey sand	122	173

Information upon completion of well:

(1) Diameter 2 inches.

(2) Total Depth 173 feet.

(3) Water Level 146 feet below top of ground.

(4) Cased to 168, Size 2


(5) Screen: Size 2, Length 5

(6) Were any formations sealed against pollution?
_____ yes, no.

If YES depth of formation _____

Why _____

Drillers Remarks: _____

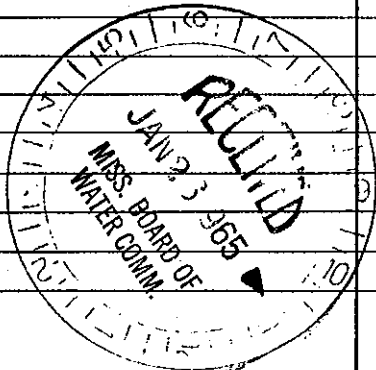

(Use Back Side)

Well No.

Mail this copy to Board of Water Commissioners 429 Miss. St. Jackson, Miss.