

**JACKSON CHOCTAW**  
MISSISSIPPI BOARD OF WATER COMMISSIONERS


K 7  
5-21-66

**WATER WELL DRILLERS LOG**

CODED

Date: 5-21, 1966, Driller: MERRITT DRILLING CO County CHOCTAW  
(Name)

(1) Owner of Land: <u>FRANK &amp; HENRY</u> (Name)	Description & Color of Materials Sand, Clay, Red Clay, Shell, etc.	Thick- ness Feet	Depth Feet
<u>ash</u>	TOP SOIL	0	2
(2) Location: <u>321</u> <u>600</u> (Address) <u>1/4</u> <u>1/4</u> <u>1/4</u> <u>1/4</u> Sec. T R	RED SAND & CLAY	2	19
<u>7</u> miles <u>N.W.</u> of <u>LOUISVILLE</u> (distance) (direction) (Nearest Town)	YELLOW CLAY & SAND	19	22
(3) Topography: <u>Hilly</u> (Hilly) (Flat) (Level)	BLUE CLAY	22	32
(4) Purpose of Well: <u>DOMESTIC</u> (Domestic Irrigation Municipal, Industrial, Other)	LIGNITE	32	35
Information upon completion of well:	BLUE CLAY	35	37
(1) Diameter <u>2</u> inches.	GREEN CLAY	37	59
(2) Total Depth <u>315</u> feet.	BLUE CLAY	59	72
(3) Water Level <u>150</u> feet below top of ground.	HARD BLUE SAND	72	76
(4) Cased to <u>189</u> , Size <u>2</u>	LIGNITE	76	79
(5) Screen: Size <u>Open</u> , Length _____	HARD BLUE SAND	79	82
(6) Were any formations sealed against pollution? _____ yes, _____ no.	GREY CLAY	82	86
If YES depth of formation _____	LIGNITE	86	89
Why _____	THIN ROCK		
Drillers Remarks: <u>SHALE TRAP</u> <u>AT END OF CASING</u>	BLUE CLAY	89	126
	BLUE CLAY & SILT	126	140
	BLUE CLAY & SAND	140	148
	BLUE SAND	148	164
	BLUE SILT & SAND	164	210
	BLUE CLAY & SAND	210	303
	THIN ROCK		
	BLUE SAND & SHALE	303	315

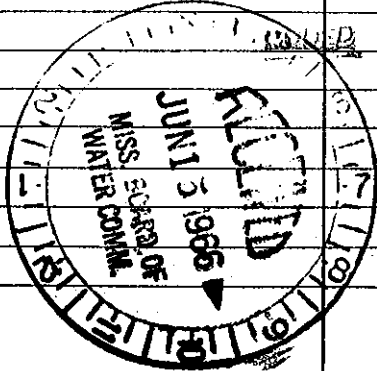

Well No.

(Use Back Side)

Mail this copy to Board of Water Commissioners 429 Miss. St. Jackson, Miss.