

CHOCTAW MISSISSIPPI BOARD OF WATER COMMISSIONERS

~~8-5-64~~ K10

WATER WELL DRILLERS LOG

Date: 8-5, 1964, Driller: MEARITT DRILLING Co County: CHOCTAW
(Name)

CODED

(1) Owner of Land: BRYANT McKnight
(Name)
ACKERMAN, Miss
(Address)

(2) Location: 1/4, 1/4, 16 11 Sec. T R
2 miles South, of Ackerman,
(distance) (direction) (Nearest Town)

(3) Topography: Hilly
(Hilly) (Flat) (Level)

(4) Purpose of Well: Domestic
(Domestic Irrigation, Municipal, Industrial, Other)

Description & Color of Materials Sand, Clay, Red Clay, Shell, etc.	Thick- ness Feet	Depth Feet
Red CLAY	0	17
SAND ROCK	17	
Yellow clay	17	20
White clay	20	21
Blue clay	21	37
Green clay	37	40
LIGNITE	40	43
Blue clay	43	77
SAND ROCK	77	
Blue Gumbo	77	80
Rock	80	
Blue Gumbo	80	82
Rock	82	
Blue clay + fine sand	82	120
Blue Gumbo	120	139
LIGNITE	139	140
Blue Gumbo	140	165
LIGNITE	165	168
Blue Gumbo	168	210
Blue clay + sand	210	289
HARD ROCK	289	290
Blue clay + sand	290	310
LIGNITE	310	312
Fine Blue sand + shale	312	315

Information upon completion of well:

(1) Diameter 2 inches.

(2) Total Depth 315 feet.

(3) Water Level 168 feet below top of ground.

(4) Cased to 189, Size 2"


(5) Screen: Size open, Length _____

(6) Were any formations sealed against pollution?
 yes, no.

If YES depth of formation SHALE top
SAND 189'

Why _____

Drillers Remarks: _____

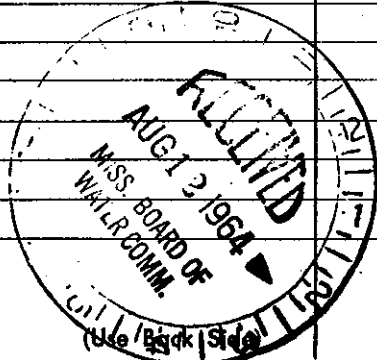

Well No. _____

Mail this copy to Board of Water Commissioners 429 Miss. St. Jackson, Miss.