

CHOCTAW MISSISSIPPI BOARD OF WATER COMMISSIONERS

L 1

WATER WELL DRILLERS LOG

9-21-63

Date: 9-21, 1963, Driller: Smith & Presley, County: Choctaw

(Name)

(1) Owner of Land: Henry H. Moore  
(Name)  
R Mc. Cool Miss  
(Address)

(2) Location: 8 1/2 NE 1/4 NE 1/4, Sec. 22 T15 R10,  
9 miles south of Weir  
(distance) (direction) (Nearest Town)

(3) Topography: Hilly  
(Hilly) (Flat) (Level)

(4) Purpose of Well: Domestic  
(Domestic Irrigation  
Municipal, Industrial, Other)

Description & Color of Materials Sand, Clay, Red Clay, Shell, etc.	Thick- ness Feet	Depth Feet
Yellow sand		
Clay	10	10
Sandy clay rock	2	12
a pad light		
blue clay	9	21
yellow clay	5	26
yellow clay		
blue mixture	3	29
black clay	10	39
yellow clay	4	43
yellow clay		
a trace of sand	86	129
a yellow clay		
Rock	8"	
blue clay	22	152
thin sand rock		
black crumbly		
clay		
hard pan		
gray sand	18	177

Information upon completion of well:

(1) Diameter 2 inches.

(2) Total Depth 177 feet.

(3) Water Level 50 feet below top of ground.

(4) Cased to 170', Size 2


(5) Screen: Size 1/4", Length 6'

(6) Were any formations sealed against pollution?  
no yes, \_\_\_\_\_ no.

If YES depth of formation \_\_\_\_\_

Why \_\_\_\_\_

Drillers Remarks: \_\_\_\_\_

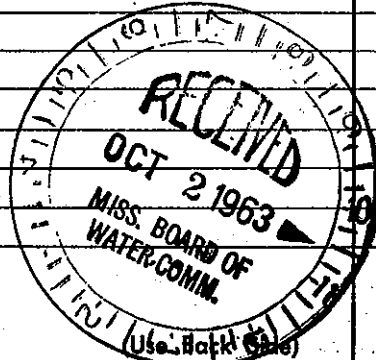

45 Well No.

Mail this copy to Board of Water Commissioners 429 Miss. St. Jackson, Miss