

CHOCTAW MISSISSIPPI BOARD OF WATER COMMISSIONERS

L 2

CODED

8-11-65

WATER WELL DRILLERS LOG

Date: 8-11, 1965, Driller: Mearitt Davenport County: Choctaw
(Name)

(1) Owner of Land:	Description & Color of Materials Sand, Clay, Red Clay, Shell, etc.	Thick- ness Feet	Depth Feet
<u>R.C. STEVENSON</u> (Name) <u>RT. 1 - Weir, Miss.</u> (Address)	TOP SOIL	5	2
(2) Location: $\frac{1}{4}$, <u>20</u> Sec. <u>15</u> T. <u>10</u> R.	Red clay	2	6
<u>10</u> miles <u>South</u> , of <u>Weir</u> (distance) (direction) (Nearest Town)	Blue clay	6	30
(3) Topography: <u>Hilly</u> (Hilly) (Flat) (Level)	Blue clay + sand	30	38
(4) Purpose of Well: <u>Domestic</u> (Domestic Irrigation Municipal, Industrial, Other)	Fine Blue sand	38	147
	+ shale	38	147
	medium coarse	147	168
	Blue sand	168	198
	TAN SAND	198	210
	Blue sand	198	210


Information upon completion of well:

- (1) Diameter 2 inches.
- (2) Total Depth 210 feet.
- (3) Water Level 40 feet below top of ground.
- (4) Cased to 189, Size 2"
- (5) Screen: Size 1/4", Length 6'
- (6) Were any formations sealed against pollution?
_____ yes, no.

If YES depth of formation _____

Why _____

Drillers Remarks: _____

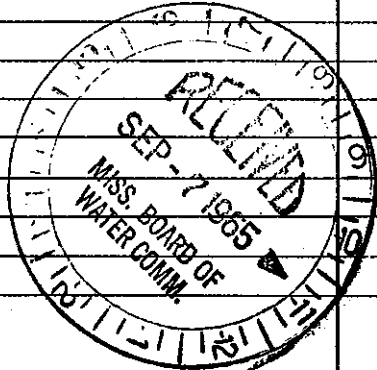

(Use Back Side)

Well No.

Mail this copy to Board of Water Commissioners 429 Miss. St. Jackson, Mis.