

CHOCTAW MISSISSIPPI BOARD OF WATER COMMISSIONERS

L3  
3-22-66

WATER WELL DRILLERS LOG


Date: 3-22, 1966, Driller: MERRITT DRILLING <sup>RODED</sup> County Choctaw  
(Name)

(1) Owner of Land: <u>MT Zion Church</u> (Name) <u>RT #1 Weir, Miss</u> (Address) <u>151510</u>	Description & Color of Materials Sand, Clay, Red Clay, Shell, etc.	Thick- ness Feet	Depth Feet
	<u>Red clay</u>	<u>0</u>	<u>4</u>
(2) Location: <u>1/4, 1/4, Sec. T R</u> <u>8 miles South</u> , of <u>Weir</u> (distance) (direction) (Nearest Town)	<u>Red sand &amp; clay</u>	<u>4</u>	<u>18</u>
	<u>TAN SAND</u>	<u>18</u>	<u>22</u>
(3) Topography: <u>Hilly</u> (Hilly) (Flat) (Level)	<u>PINK SAND very fine</u>	<u>22</u>	<u>42</u>
	<u>TAN SAND very fine</u>	<u>42</u>	<u>80</u>
(4) Purpose of Well: <u>church</u> (Domestic Irrigation Municipal, Industrial, Other)	<u>Blue sand very fine</u>	<u>80</u>	<u>95</u>
	<u>COARSE TAN SAND</u>	<u>95</u>	<u>138</u>

Information upon completion of well:

- (1) Diameter 2 inches.
- (2) Total Depth 138 feet.
- (3) Water Level 45 feet below top of ground.
- (4) Cased to 126, Size 2
- (5) Screen: Size 1 1/4", Length 6'
- (6) Were any formations sealed against pollution?  
yes,  no.

If YES depth of formation \_\_\_\_\_  
Why \_\_\_\_\_  
Drillers Remarks: \_\_\_\_\_

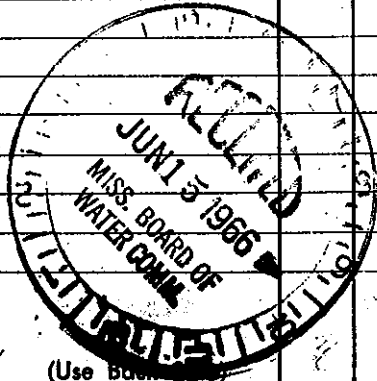

Well No. \_\_\_\_\_

Mail this copy to Board of Water Commissioners 429 Miss. St. Jackson, Miss.