

CHOCTAW MISSISSIPPI BOARD OF WATER COMMISSIONERS

CODED 301

6 L5  
9-30-60

WATER WELL DRILLERS LOG

Date: 9/20, 1960, Driller: L. K. Merritt County Choctaw  
(Name)

(1) Owner of Land: H. Moore  
(Name)  
Akerman Miss.  
(Address)

(2) Location:  $\frac{1}{4}$ , 28,  $\frac{1}{4}$ , Sec. 15, 10  
T. R.  
2 miles S/W, of Autburn  
(distance) (direction) (Nearest Town)

(3) Topography:  (Hilly)  (Flat)  (Level)

(4) Purpose of Well: Domestic  
(Domestic Irrigation, Municipal, Industrial, Other)

| Description & Color of Materials<br>Sand, Clay, Red Clay, Shell, etc. | Thick-<br>ness<br>Feet | Depth<br>Feet |
|---|------------------------|---------------|
| <u>Red sand</u>   | <u>0</u>               | <u>48</u>     |
| <u>White Clay &amp; sand</u>  | <u>48</u>              | <u>82</u>     |
| <u>Fine White sand</u>  | <u>32</u>              | <u>97</u>     |
| <u>5' Gauge # 80 - outside</u>  |                        |               |

Information upon completion of well:

(1) Diameter 2 inches.

(2) Total Depth 97 feet.

(3) Water Level 43 feet below top of ground.

(4) Cased to 9789, Size 2


(5) Screen: Size 1/4, Length 5'

(6) Were any formations sealed against pollution?  
yes,  no.

If YES depth of formation \_\_\_\_\_

Why \_\_\_\_\_

Drillers Remarks: \_\_\_\_\_

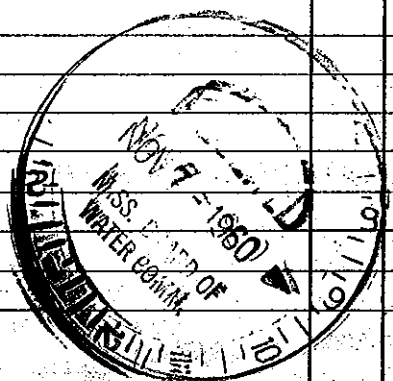

(Use Back Side)

Well No.

Mail this copy to Board of Water Commissioners 429 Miss. St. Jackson, Miss.