

CHOCTAW

MISSISSIPPI BOARD OF WATER COMMISSIONERS

~~6~~ L6  
11-10-61

WATER WELL DRILLERS LOG

CODE 6-302

Date: 11/10/1961, Driller: E. H. Merritt County Choctaw  
(Name)

(1) Owner of Land:	Description & Color of Materials Sand, Clay, Red Clay, Shell, etc.	Thick- ness Feet	Depth Feet
(Name) <u>Garry Hannod</u> <u>Ackerman Miss.</u> (Address)	<u>Argoese clay</u> <u>Coarse white sand</u>	<u>0</u> <u>10</u>	<u>10</u> <u>84</u>
(2) Location: <u>11</u> / <u>15</u> / <u>10</u> <u>5</u> miles <u>S.W.</u> of <u>ACKERMAN</u> (distance) (direction) (Nearest Town)			
(3) Topography: <input checked="" type="checkbox"/> (Hilly) <input type="checkbox"/> (Flat) <input type="checkbox"/> (Level)			
(4) Purpose of Well: <u>Domestic</u> (Domestic Irrigation Municipal, Industrial, Other)			


Information upon completion of well:

- (1) Diameter 2 inches.
- (2) Total Depth 84 feet.
- (3) Water Level 70 feet below top of ground.
- (4) Cased to 78, Size 2
- (5) Screen: Size 1/4, Length 6'
- (6) Were any formations sealed against pollution?  
 yes,  no.

If YES depth of formation \_\_\_\_\_

Why \_\_\_\_\_

Drillers Remarks: \_\_\_\_\_

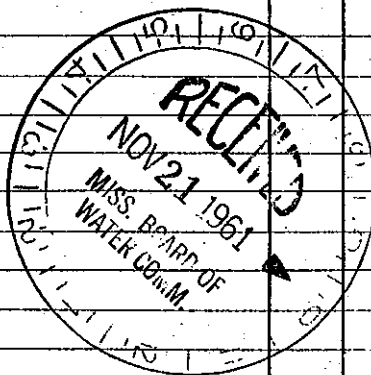

Well No.

(Use Back Side)

Mail this copy to Board of Water Commissioners 429 Miss. St. Jackson, Miss