

Clairborne  
 C2000  
 11-67


MISSISSIPPI  
 BOARD OF WATER COMMISSIONERS  
 416 North State Street  
 Jackson, Mississippi 39201

WATER WELL DRILLERS LOG

11-30 1967 E B Fore Clairborne  
 date well completed firm name county well located

LANDOWNER: Henry B Mc Kowen (Heavenly Hill Ranch) 2775 Mc Connell Dr. Baton Rouge La - (mailing address)	description of formations encountered	from	to
	Brown Silty Cl	0	23
WELL LOCATION: sec 33 T. 13 N R 3 E 15 miles NE Atkinson (distance) (direction) (nearest town)	Deer Camp - White Clay, with Sand streaks	23	63
	Blue Clay	63	97
WELL PURPOSE: Deer Camp - (home, irrigation, municipal, industrial)	Sand	97	113

WELL COMPLETION DATA:  
 (1) diameter (inches) 4 1/4  
 (2) total depth (feet) 113  
 (3) static water level (feet) 85 below top of ground.  
 (4) casing Galv 108 (material) (depth)  
 No (size) if telescope see back.  
 (5) screen 5' 108 (length) (depth to top)  
 2" SS (size) (material)  
 (6) pump 3/4 6 (HP) (yield gpm)  
 Elec (type power)  
 (7) electric log NO (yes or no)  
 None (organization running log)  
 (8) B.W. Valve (top well bottom plugged)

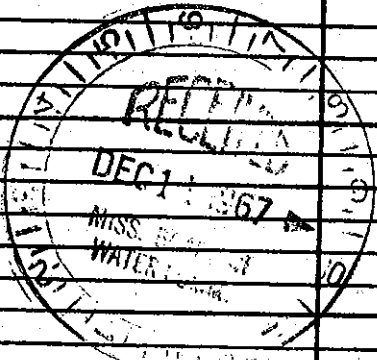

DRILLERS REMARKS: