

Claborne  
E 001  
12-66

MISSISSIPPI  
BOARD OF WATER COMMISSIONERS  
416 North State Street  
Jackson, Mississippi 39201

WATER WELL DRILLERS LOG



12-15 1966 EB Fore Drl. Co. Claborne  
date well completed firm name county well located

LANDOWNER: <u>White Hall</u> <u>Deer Camp</u> <u>PO DAN M &amp; CAY - Port Gibson</u> (mailing address)	description of formations encountered	from	to
	<u>Sand</u>	<u>0</u>	<u>90</u>
	<u>Sand &amp; gravel</u>	<u>90</u>	<u>120</u>

WELL LOCATION:  
sec 12 T 12 N R 1 E  
20 miles W Port Gibson  
(distance) (direction) (nearest town)

WELL PURPOSE: Deer Camp  
(home, irrigation, municipal, industrial)

- WELL COMPLETION DATA:
- (1) diameter (inches) 6 1/2"
  - (2) total depth (feet) 120'
  - (3) static water level (feet) 48' below above top of ground.
  - (4) casing Plastic 114'  
(material) (depth)  
4"  
(size) if telescope see back.
  - (5) screen 6' 114'  
(length) (depth to top)  
4" Plastic  
(size) (material)
  - (6) pump 1/2 10  
(HP) (yield gpm)  
Sub  
(type power)
  - (7) electric log No.  
(yes or no)  
(organization running log)
  - (8) how well bottom plugged Back with  
John

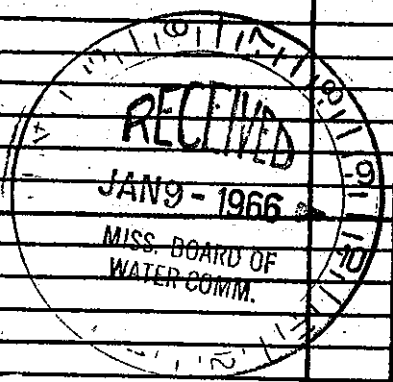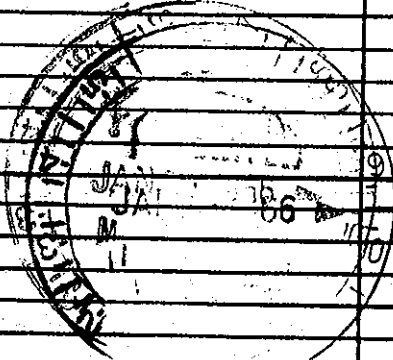

DRILLERS REMARKS:  
(over)