

CLAIBORNE MISSISSIPPI BOARD OF WATER COMMISSIONERS

F 7
4-8-66

WATER WELL DRILLERS LOG


ELOG # 57

CODED

Date: 8 April, 1966, Driller: WATERWELLS, INC. Claiborne

329 (Name)

	Description & Color of Materials Sand, Clay, Red Clay, Shell, etc.	Thick- ness Feet	Depth Feet
(1) Owner of Land: <u>L. A. Caruthers</u> (Name) <u>3300 Washington St, Vicksburg, Miss</u> (Address)	Loess Deposits	40	0
	Greyish clay	93	40
	Clay rock -hard streaks	19	133
(2) Location: <u>12 1/2 R 2E</u> <u>5</u> miles <u>NW</u> , of <u>Port Gibson</u> (distance) (direction) (Nearest Town)	Coarse white sand	68	150 ✓
	Hard clay rock (limestone)	22	218
	Coarse white sand		240
(3) Topography: <u>Very Hilly</u> (Hilly) (Flat) (Level)			
(4) Purpose of Well: <u>Domestic</u> (Domestic Irrigation Municipal, Industrial, Other)			
Information upon completion of well: (1) Diameter <u>4 X 2</u> inches. (2) Total Depth <u>240'</u> feet. (3) Water Level <u>118'</u> feet below top of ground. (4) Cased to <u>240'</u> , Size <u>4 & 2"</u> (5) Screen: Size <u>2"</u> , Length <u>20"</u> (6) Were any formations sealed against pollution? <u>X</u> yes, _____ no. If YES depth of formation <u>top 10'</u> Why <u>Seal off surface water</u> Drillers Remarks: <u>Hard drilling all the way down; well at Lake Claiborne; pumping steady at 15 gpm & 20psi</u>	CODED	242	

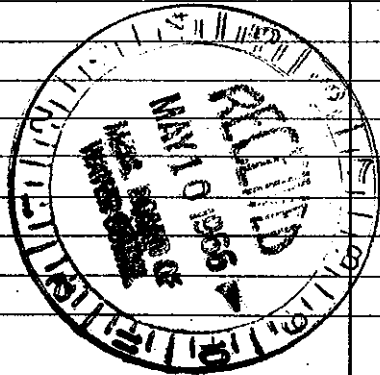

(Use Back Side)

Well No.

Mail this copy to Board of Water Commissioners 429 Miss. St. Jackson, Miss.