

Clatsone
 F 10
 7-68
 Miss Geo Sweeney
 July 1968

MISSISSIPPI
 BOARD OF WATER COMMISSIONERS
 416 North State Street
 Jackson, Mississippi 39201

CODED

WATER WELL DRILLERS LOG

Clatsone
 county well located

LANDOWNER: Anderson

description of formations
 encountered

from

to

Walker
 R. D. Post Station
 (mailing address)

Brown s.s., cl

6 30

Red s.s., cl

30 70

White cl

70 82

Blue cl

82 110

Sol

110 116


WELL LOCATION:

sec. 28 T. 12 N R. 2 E
 5 miles W of Pt. Abino
 (distance) (direction) (nearest town)

WELL PURPOSE: Home
 (home, irrigation, municipal, industrial)

WELL COMPLETION DATA:

- (1) diameter (inches) 4 1/4
- (2) total depth (feet) 116
- (3) static water level (feet) 88 below top of ground.
- (4) casing Galv. 111' (material) (depth)
- (size) if telescope see back.
- (5) screen 5 111 (length) (depth to top)
- 2 53 (size) (material)
- (6) pump 1/2 3 (HP) (yield gpm)
- Elec (type power)
- (7) electric log Yes (yes or no)
- Miss Geo Sweeney (organization running log)
- (8) how well bottom plugged B.W.

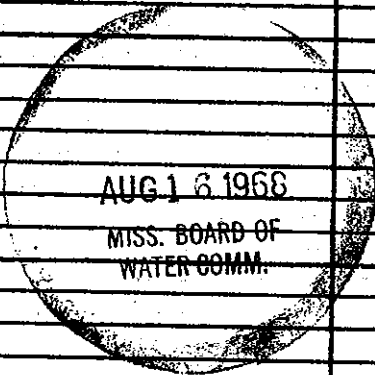

DRILLERS REMARKS:

Well logged to 297 T.D.