

CLAIBORNE

F 14

2-1-62

WATER WELL DRILLERS LOG

CODED

Date: 2/1, 1962, Driller: Johnnie Beasley, County Claiborn

959

(Name)

(1) Owner of Land: Richard Moore
 (Name)
Rt. 2, Box 17, Port Gibson, Miss.
 (Address)
 This well located 3 miles North of
 (2) Location: 1/4, 1/4, Sec. 12-12-26
Port Gibson on 61 Hwy. turn West 2 1/2
Miles. 5 1/2 miles Northwest of Port Gibson.
 (distance) (direction) (Nearest Town)

(3) Topography: x
 (Hilly) (Flat) (Level)

(4) Purpose of Well: Domestic
 (Domestic Irrigation
 Municipal, Industrial, Other)

Description & Color of Materials Sand, Clay, Red Clay, Shell, etc.	Thick- ness Feet	Depth Feet
Clay.	52	52
Rock & clay.	10	62
Clay.	47	109
Rock.	5	114
Hard clay.	28	142
Rock & hard clay.	10	152
Clay & stks. mucky sand.	10	162
Hard clay.	20	182
Clay & stks. rock.	10	192
Sand. (Screen setting.)	8	200

Information upon completion of well:

- (1) Diameter 2 inches.
- (2) Total Depth: 200 feet.
- (3) Water Level _____ feet below top of ground.
- (4) Cased to 190', Size 2"
- (5) Screen: Size 2", Length 10'
- (6) Were any formations sealed against pollution?
 _____ yes, x no.


If YES depth of formation _____

Why _____

Drillers Remarks: Good well.

tain this copy for your office files.

CODED

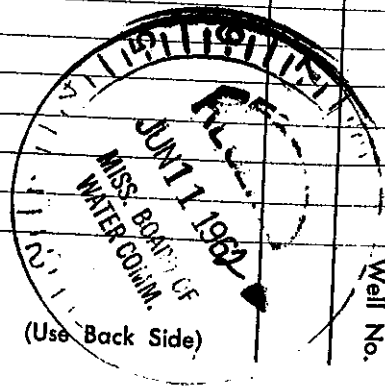

Well No.

(Use Back Side)