

CLAYBORNE MISSISSIPPI BOARD OF WATER COMMISSIONERS

2 F 17
6-30-66

WATER WELL DRILLERS LOG

CODED

Date: 6/30, 1966, Driller: C. RIVER WATERWELL ⁵⁶⁰⁰ County CLAYBORNE
(Name)

135

(1) Owner of Land:	Description & Color of Materials Sand, Clay, Red Clay, Shell, etc.	Thick- ness Feet	Depth Feet
<u>J. T. BINDER</u> (Name) <u>RT. 2 PORT GIBSON</u> (Address)	<u>TOP SOIL</u>	1	1
(2) Location: <u>1/4</u> , <u>1/4</u> , Sec. <u>1 T12R2E</u>	<u>CLAY</u>	75	76
<u>10</u> miles <u>NORTH</u> , of <u>PORT GIBSON</u> (distance) (direction) (Nearest Town)	<u>COURSE SAND</u>	14	90
(3) Topography: <u>HILLY</u> (Hilly) (Flat) (Level)	<u>BLUE CLAY</u>	20	110
(4) Purpose of Well: <u>HOME</u> (Domestic Irrigation Municipal, Industrial, Other)	<u>FINE SAND</u>	30	140

Information upon completion of well:


- (1) Diameter 2 inches.
- (2) Total Depth 140 feet.
- (3) Water Level 90 feet below top of ground.
- (4) Cased to 133, Size 2"
- (5) Screen: Size 2", Length 5 FT.
- (6) Were any formations sealed against pollution?
no

If YES depth of formation _____

Why _____

Drillers Remarks: _____

CODED

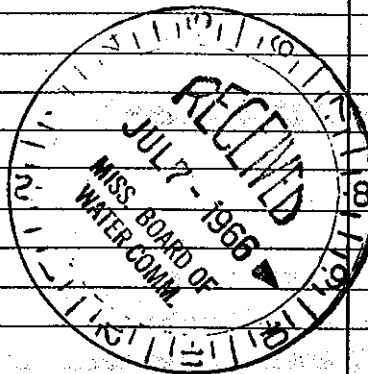

Well No. _____

(Use Back Side)

Mail this copy to Board of Water Commissioners 429 Miss. St. Jackson, Miss.