

Clairborne
F2001
108

MISSISSIPPI
BOARD OF WATER COMMISSIONERS
416 North State Street
Jackson, Mississippi 39201

WATER WELL DRILLERS LOG

1968 ER FORE Clairborne
date well completed firm name county well located

LANDOWNER: Edward G Ellis - Rtd
Port Gibson, Miss
(mailing address)

description of formations encountered	from	to
<u>Brown Clay</u>	<u>0</u>	<u>30</u>
<u>Gravel</u>	<u>30</u>	<u>33</u>
<u>Blue Clay</u> <u>+ Hard Sd Rock</u>	<u>33</u>	<u>123</u>
<u>Sand -</u>	<u>123</u>	<u>132</u>

WELL LOCATION:
sec 35 T. 12 N. R. 2 E
3 miles N Port Gibson
(distance) (direction) (nearest town)

WELL PURPOSE: Home
(home, irrigation, municipal, industrial)

WELL COMPLETION DATA:

(1) diameter (inches) 1-1/4

(2) total depth (feet) 131

(3) static water level (feet) _____ below/above top of ground.

(4) casing Galv, 126
(material) (depth)

_____ (size) if telescope see back.

(5) screen 5, 126
(length) (depth to top)

2, SS
(size) (material)


(6) pump 1/2, _____
(HP) (yield gpm)

Elec
(type power)

(7) electric log No
(yes or no)

None
(organization running log)

(8) B.W. Value
bottom plugged

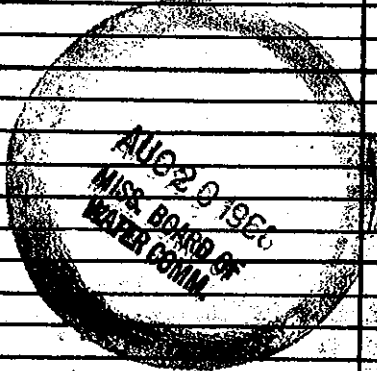

DRILLERS REMARKS: