

MISSISSIPPI
BOARD OF WATER COMMISSIONERS
416 North State Street
Jackson, Mississippi 39201


WATER WELL DRILLERS LOG

Claiborne
F 2002
68

date well completed 19 68 firm name E B Fore county well located Claiborne

LANDOWNER: <u>DONALD</u> <u>Crisler</u> <u>Port, Gibson</u> (mailing address)	description of formations encountered	from	to
	<u>Brown Clay</u>	<u>0</u>	<u>45</u>
	<u>Gravel</u>	<u>45</u>	<u>50</u>
WELL LOCATION: sec <u>28</u> T <u>12</u> N R <u>2</u> E <u>4</u> miles <u>W</u> of <u>Port Gibson</u> (distance) (direction) (nearest town)	<u>Clay & Gravel</u>	<u>50</u>	<u>76</u>
	<u>Blue cl.</u>	<u>76</u>	<u>163</u>
WELL PURPOSE: <u>Home</u> (home, irrigation, municipal, industrial)	<u>Sand</u>	<u>163</u>	<u>190</u>

- WELL COMPLETION DATA:
- (1) diameter (inches) 4 1/4
 - (2) total depth (feet) 190
 - (3) static water level (feet) 160 below above top of ground.
 - (4) casing Galv. 180
(material) (depth)
(size) if telescope see back.
 - (5) screen 10 180
(length) (depth to top)
2 SS
(size) (material)
 - (6) pump 1/4 4
(HP) (yield gpm)
Elec
(type power)
 - (7) electric log No
(yes or no)
None
(organization running log)
 - (8) how well bottom plugged BWU

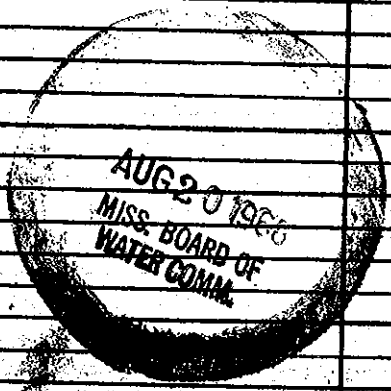

DRILLERS REMARKS: