

CLAIBORNE

G 17

1-29-62

# WATER WELL DRILLERS LOG **CODED**

Date: 1/29, 1962, Driller: Johnnie Beasley County Claiborn

2894

(Name)

(1) Owner of Land	Description & Color of Materials Sand, Clay, Red Clay, Shell, etc.	Thick- ness Feet	Depth Feet
Mrs. E. L. Yancey (Name)	Brown clay.	22-	22
Port Gibson, Miss.	Red sand & gravel.	10-	32
This well located <sup>(Address)</sup> 4 miles North of	Red sand.	50-	82
(2) Location: $\frac{1}{4}$ , $\frac{1}{4}$ , Sec. <u>7 1/2, 35</u>	Sand & stks. clay.	8-	90
Port Gibson on Hwy. 61.	Sand. (Screen Setting.)	10-	100
_____ miles _____, of _____	Clay.	10-	110
(3) Topography: <input checked="" type="checkbox"/> (Hilly) <input type="checkbox"/> (Flat) <input type="checkbox"/> (Level)	Fine sand.	2-	112
(4) Purpose of Well: <u>Domestic</u>	Clay.	6-	118
(Domestic Irrigation Municipal, Industrial, Other)	Fine sand & stks. clay.	14-	132
	Clay & rock.	40-	172
	Hard clay & stks. rock.	40-	212

Information upon completion of well:


- (1) Diameter 2 inches.
- (2) Total Depth 100 feet.
- (3) Water Level 87 feet below top of ground.
- (4) Cased to 90', Size 2"
- (5) Screen: Size 2", Length 10'
- (6) Were any formations sealed against pollution?  
no yes,  no.

**CODED**

If YES depth of formation \_\_\_\_\_

Why \_\_\_\_\_

Drillers Remarks: Medium well.

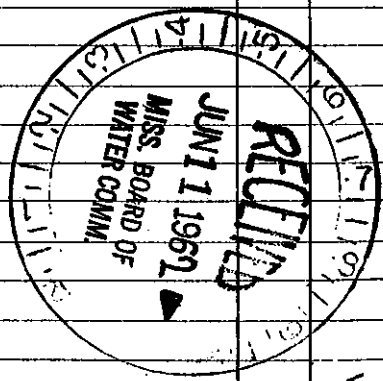

Well No.

(Use Back Side)

Retain this copy for your office files.