

CLAIBORNE MISSISSIPPI BOARD OF WATER COMMISSIONERS

G18

WATER WELL DRILLERS LOG

CODED

1-31-62

Date: 1/31, 1962, Driller: Johnnie Beasley County: Claiborn

2899

(Name)

(1) Owner of Land	Description & Color of Materials Sand, Clay, Red Clay, Shell, etc.	Thick- ness Feet	Depth Feet
Mrs. E. L. Yancey. (Name) Port Gibson, Miss. (Address)	Brown clay.	22-	22
This well located 4 miles North of (2) Location: 1/4, 1/4, Sec. 19, 20, 11 R2E, Port Gibson on Hwy. 61. 7 12 SE miles. of (distance) (direction) (Nearest Town)	Clay & red sand.	10-	32
(3) Topography: <input checked="" type="checkbox"/> (Hilly) <input type="checkbox"/> (Flat) <input type="checkbox"/> (Level)	Red sand.	10-	42
(4) Purpose of Well: Domestic. (Domestic Irrigation Municipal, Industrial, Other)	Sand. (Screen setting.)	44-	86
	Hard clay & rock.	16-	102

Information upon completion of well:


- (1) Diameter 2" inches.
- (2) Total Depth 86 feet.
- (3) Water level _____ feet below top of ground.
- (4) Cased to 76', Size 2"
- (5) Screen: Size 2", Length 10'
- (6) Were any formations sealed against pollution?
_____ yes, no.

If YES depth of formation _____

Why _____

Drillers Remarks: Medium well.

CODED

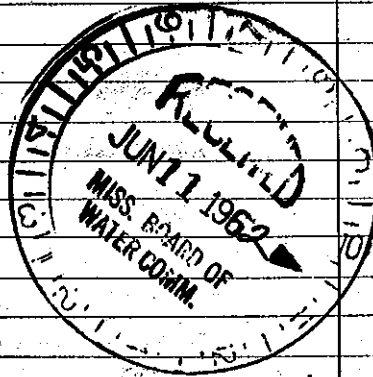

Well No.

(Use Back Side)

Mail this copy to Board of Water Commissioners 429 Miss. St. Jackson, Miss