

Claiborne

G 2000

10-66

MISSISSIPPI BOARD OF WATER COMMISSIONERS

WATER WELL DRILLERS LOG

Date: Oct 15, 1966, Driller: E B F O R E County: Claiborne

(Name)

(1) Owner of Land:	Description & Color of Materials Sand, Clay, Red Clay, Shell, etc.	Thick- ness Feet	Depth Feet
Lewis DAVIS (Name)	Brown Sdy Clay	13	13
Port Gibson, Miss (Address)	White Clay	5	18
(2) Location: 1/4, 1/4, Sec. 45 T2N R3E	Sand	2	20
4 miles E. Port Gibson (distance) (direction) (Nearest Town)	White Clay	3	23
(3) Topography: Hilly (Hilly) (Flat) (Level)	Sand	77	110
(4) Purpose of Well: Domestic (Domestic Irrigation Municipal, Industrial, Other)			

Information upon completion of well:

- (1) Diameter 4 inches.
- (2) Total Depth 110' feet.
- (3) Water Level 76' feet below top of ground.
- (4) Cased to 105', Size 2"
- (5) Screen: Size .08, Length 5'
- (6) Were any formations sealed against pollution?
yes, no.

If YES depth of formation


Why

Drillers Remarks:

H.T.H. Tablets

Sealed top casing with

sacks - Owner will cement slabs (Use Back Side)

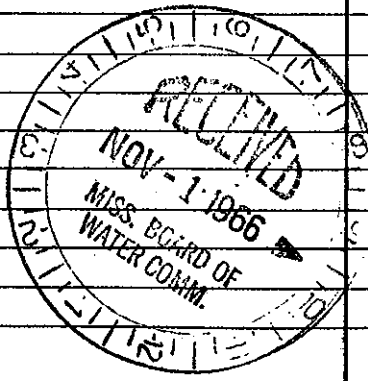

Well No.