

Clairborne
 G 2001
 9-67

MISSISSIPPI
 BOARD OF WATER COMMISSIONERS
 416 North State Street
 Jackson, Mississippi 39201

WATER WELL DRILLERS LOG

Sept 25 1967 EB Fore Clairborne
 date well completed firm name county well located


LANDOWNER: L R Ashley
 Hwy 61 - North
 Port Gibson Miss
 (mailing address)

description of formations encountered	from	to
Brown Sdy Cl	0	30
White + Brown Cl	30	70
Sandy Clay	70	80
fine sand	80	93
Sd Rock	93	100
Blue Cl + Sd Rock	100	360
Stretch - Sd Str		
Sand -	360	400

WELL LOCATION:
 sec 7 T 12 N R 3 E
 5 miles N Ft. Gibson
 (distance) (direction) (nearest town)

WELL PURPOSE: Home
 (home, irrigation, municipal, industrial)

WELL COMPLETION DATA:
 (1) diameter (inches) 4 1/2
 (2) total depth (feet) 400
 (3) static water level (feet) 177 below top of ground.
 (4) casing Galv. 385' (material) (depth)
 (size) if telescope see back.
 (5) screen 1.5" 385' (length) (depth to top)
 2 SS (size) (material)
 (6) pump 2 6 (HP) (yield gpm)
 Elec (type power)
 (7) electric log No (yes or no)
 NONE (organization running log)
 (8) how well bottom plugged Rockward valve

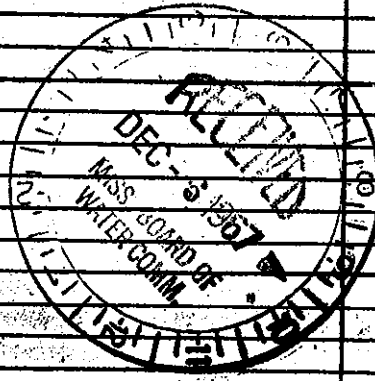

DRILLERS REMARKS: