

Claiborne
G 2003
2-67

MISSISSIPPI
BOARD OF WATER COMMISSIONERS
416 North State Street
Jackson, Mississippi 39201

WATER WELL DRILLERS LOG

2-15

W E B F O R E

Claiborne

date well completed

firm name

county well located

LANDOWNER:	description of formations encountered	from	to
Thomas J. White - Rt 1			
Box 161 - Hermanville, Miss. (mailing address)	Brown Sh Cl	0	14
	White Cl	14	15
	Brown Sad.	15	20
		20	30
		30	70
	White Cl	70	72
	Blue Cl + White	72	75
	White Sh - fine	75	78
		78	81
	Cl Blue + Brown	81	88
		88	100
	Blue Cl + Sand	100	120
	Blue Cl	120	151
	Sand + Red + Blue	151	160
	Coarse Sh.	160	170
		170	180
	Bl Cl	180	


WELL LOCATION:

sec 37 T 12 N R 3 E
4 miles E Port Gibson
(distance) (direction) (nearest town)

WELL PURPOSE: Home
(home, irrigation, municipal, industrial)

WELL COMPLETION DATA:

- (1) diameter (inches) 4
- (2) total depth (feet) 167
- (3) static water level (feet) 136 below top of ground.
- (4) casing (material) Galv (depth) 157
- (5) screen (length) 10 (depth to top) 157
- (6) pump (HP) 1 1/2 (yield gpm) 6
- (7) electric log (yes or no) No
- (8) how far bottom plugged

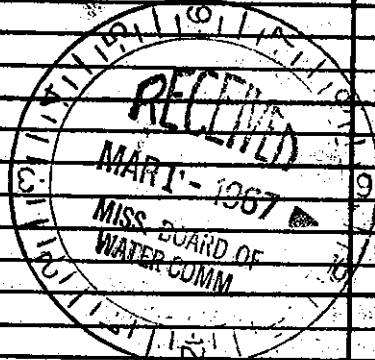

DRILLERS REMARKS: