

State Well Report

Part 1

Mississippi Department of Environmental Quality
Office of Land and Water Resources
P.O. Box 10631
Jackson, MS 39289-0631
(601)961-5210
(601)354-6938 (fax)

For Office Use Only:

Aquifer: H 39
Well #: _____
L. S. Elevation: _____
E-log #: _____

County: Claiborne
Permit #: _____
Driller: GRENN WATER WELL & SUPPLY, INC.
Date drilling completed: 8-9-11

State Law requires that this report be prepared by the driller in detail and filed with the Department within 30 days of completion of drilling of the well.

Well Owner Information	Well Location
Owner Name: <u>Drue Angelo</u>	Latitude: <u>31° 59' 16.09"</u> Longitude: <u>90° 48' 26.6"</u>
Mailing Address: <u>4956 Barataria Blvd</u>	Method of Lat/Long (circle one): Conventional Survey,
<u>Marrero LA 70072</u>	USGS quad, <u>Hand-held GPS</u> , Survey-grade GPS
City State Zip Code	<u>SW 1/4 Sec 37 Twn 12N Rng 4E</u>
Telephone No. <u>(504) 388-0907</u>	SE Direction Nearest Town <u>2</u> Miles <u>NE</u> of <u>Hermanville</u>

Well Data

Purpose of Well (circle one) Home Industrial Public Supply Irrigation Fish Culture Other: hunting camp

Date well drilling started: 8-9-11 Date well drilling completed: 8-9-11

If flowing, method of flow regulation: Valve _____ Other (describe) _____

Static Water Level: 76 feet above of below (circle one) land surface Date measured: 8-9-11

Method of Measurement (circle one) steel tape electric tape air line other: _____

Hole depth: 78 Well depth: 76 Well grouted to a depth of 10 feet

Type of grout (circle one): Cement Bentonite Mix

Casing length: 66 feet Casing diameter: 4 inches Type of casing: PVC

Screen length: 10 feet Screen diameter: 4 inches Type of screen: PVC

Screen slot size: 10/10 inches Setting depth: From 66 feet to 76 feet

Type of completion (circle all applicable): gravel packed Underreamed Telescoped Open hole Natural Development

Other (describe): _____

Top of lap pipe or reduction in casing: _____ feet. If telescoped or more than one screen, describe on back of page

Logs run (circle all applicable): No log run Electric Gamma Ray Density Sonic Neutron Other: _____

Name of organization running log(s): _____

I certify that the well was drilled, constructed, and completed in accordance with all applicable requirements of the Mississippi Department of Environmental Quality and/or the Mississippi Department of Health regulations and state laws.

GRENN WATER WELL & SUPPLY, INC.
BRIAN D. McCLENDON, UNR-00000664

Print Name of Water Well Contractor and License No.

Brian McCleendon
Signature of Water Well Contractor

BY: OWNER


If well telescopes please sketch below and show depths.

Ground Level

Description of Formations Encountered	From	To
red clay	0	22
sand w/ clay streaks	22	58
sand	58	75
hard blue clay	75	75

If more than one screen, show location of each on sketch

Sketch the property layout and include the following: 1) the well location; 2) any permanent structures on the property that may aid in locating the well; 3) any roads, power lines, or other items that may aid in locating the property and the well; 4) indicate direction.

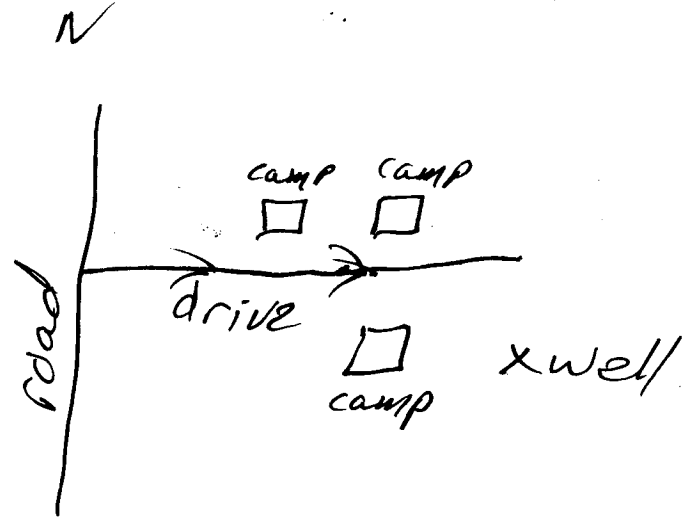

Landowner Name: Dree Angelo

Brian McCloud 664
Signature of Water Well Contractor

STATE WELL REPORT

Part 2

Pump Installer's Completion Report
 Mississippi Department of Environmental Quality
 Office of Land and Water Resources
 P.O. Box 10631
 Jackson, MS 39289-0631
 (601)961-5210
 (601)354-6938 (fax)

For Office Use Only:

Aquifer: _____
 Well #: H39
 Elevation: _____

County: Clai borne
 Permit #: _____
 Driller: GRENN WATER WELL & SUPPLY, INC.
 Date completed: 8-12-11

This report should be prepared by the pump installer in detail and filed with the Department within 30 days of the installation of pump.

Well Owner Information	Well Location
Owner Name: <u>Drue Angelo</u>	Latitude: <u>30° 59' 16.0"</u> Longitude: <u>90° 48' 06.6"</u>
Mailing Address: <u>4956 Barataria Blvd</u>	Method of Lat/Long (circle one): Conventional Survey,
<u>Marrero LA 70072</u>	USGS quad, <u>Hand-held GPS</u> , Survey-grade GPS
City State Zip Code	<u>SW 1/4 NW 1/4 Sec 37 Twn 12N Rng 4E</u>
Telephone No. <u>(504) 388-0907</u>	SE Direction Nearest Town
	<u>2</u> Miles <u>NE</u> of <u>Hermanville</u>

Pump Type Circle one	Power Type Circle one
Air Lift Jet <input type="radio"/> <u>Submersible</u>	Diesel Engine Gasoline Engine Natural Gas
Bucket Piston Turbine	<u>Electric Motor</u> Hand Tractor PTO
Centrifugal Rotary Flowing Well	Windmill Other (specify): _____
Other (specify): _____	Horse Power Rating of Motor: <u>1/2</u>
Date Pump Installed: <u>8-12-11</u>	Setting Depth: <u>73</u> feet
Rated Pump Capacity: <u>10</u> Gallons Per Minute	Number of Stages: <u>9</u>

Pump Test Data	Method of Measuring Water Level Circle one
Date Well Tested: <u>8-12-11</u>	Air Line <input type="radio"/> <u>Electric Measuring Line</u> Steel Tape
Static Water Level (A): <u>46</u> Feet <u>Below</u> Land Surface	Other (specify): _____
Pumping Water Level (B): <u>50</u> Feet Below Land Surface	For flowing well, measured shut in head: _____ feet
Drawdown [(B) - (A)]: <u>4</u> Feet Below Land Surface	Well yielded <u>11</u> GPM with a drawdown of
Test Pumping Rate: <u>11</u> Gallons Per Minute	<u>4</u> feet after <u>4</u> hours of pumping
Duration of Pump Test (minimum 4 hours): <u>4</u> hours	

I HEREBY CERTIFY that the above statements are true to the best of my knowledge.

MICHAEL W. KEES, RPO-00000801

Print Name of Pump Installer and License No. (if applicable)

Michael W. Kees
 Signature of Pump Installer

RECEIVED
 SEP 1 2011
 MISSISSIPPI DEPARTMENT OF ENVIRONMENTAL QUALITY