

CLAIBORNE MISSISSIPPI BOARD OF WATER COMMISSIONERS

H 2000
10-22-63

WATER WELL DRILLERS LOG

Clairborne
Hinds
COST

Date: 10/21, 1963, Driller: Faust Dalg Aut County (Name)

(1) Owner of Land: Con. Dey Inc
(Name)
Jackson, Miss.
(Address)

(2) Location: 1/4, 1/4, Sec. T R
miles North (direction) Hwy 61 (distance) Hermantown (Nearest Town)
Near Valley by Moon (Nearest Town)

(3) Topography: _____
(Hilly) (Flat) (Level)

(4) Purpose of Well: _____
(Domestic Irrigation Municipal, Industrial, Other)

Description & Color of Materials Sand, Clay, Red Clay, Shell, etc.	Thick- ness Feet	Depth Feet
Brown Silt	0	25
Shale		42
Sand + Sh. Clay		60
Sandy Clay		75
Blue Clay		90
Rock		95
Hard shale + Sh. Rock		123
Rock		143
Shale + Sh. Rock		186
Sand + Sh. Shale		192
Hard shale + Rock		227
Thin sand + Sh. Shale		237
Rock		238
Sand		244
Sand + Sh. Rock		266

Information upon completion of well:

(1) Diameter 2 inches.

(2) Total Depth 266 feet.

(3) Water Level 75 feet below top of ground.
147 1/2
50 1/2

(4) Cased to 246, Size _____


(5) Screen: Size 2", Length 20ft.

(6) Were any formations sealed against pollution?
yes, no.

If YES depth of formation _____

Why _____

Drillers Remarks: _____

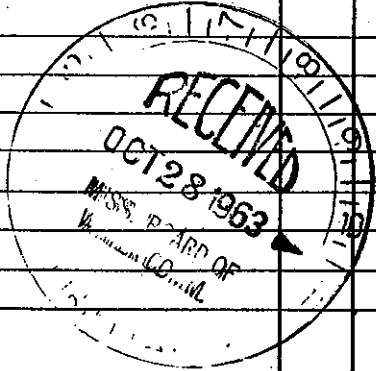

Well No.

(Use Back Side)

Mail this copy to Board of Water Commissioners 429 Miss. St. Jackson, Miss.