

MISSISSIPPI
 BOARD OF WATER COMMISSIONERS
 416 North State Street
 Jackson, Mississippi 39201

WATER WELL DRILLERS LOG


Clarksome
 H2002
 268

July 19 68 E. B. Jones Clarksome
 date well completed firm name county well located

LANDOWNER: <u>F. D. Jones</u>	Description of formations encountered	from	to
<u>Clarksome, Miss</u>	<u>Grey clay</u>	<u>0</u>	<u>13</u>
(mailing address)	<u>Sand</u>	<u>13</u>	<u>15</u>
WELL LOCATION: sec <u>27</u> T <u>12</u> N R <u>4</u> E	<u>Blue clay</u>	<u>15</u>	<u>47</u>
<u>1/4</u> miles <u>NE</u> of <u>Clarksome, Miss</u>	<u>Sand</u>	<u>47</u>	<u>64</u>
(distance) (direction) (nearest town)			

WELL PURPOSE: Home
 (home, irrigation, municipal, industrial)

- WELL COMPLETION DATA:
- (1) diameter (inches) 4 1/4
 - (2) total depth (feet) 64
 - (3) static water level (feet) 30 below above top of ground.
 - (4) casing Galv 59
 (material) (depth)
 - _____ if telescope see back.
 (size)
 - (5) screen 5 54
 (length) (depth to top)
 - 2 SS
 (size) (material)
 - (6) pump 1 6
 (HP) (yield gpm)
 - Elec
 (type power)
 - (7) electric log No
 (yes or no)
 - None
 (organization running log)
 - (8) how well bottom plugged B. W. Value

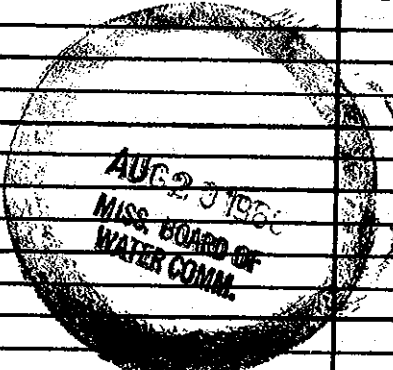

DRILLERS REMARKS: