

MISSISSIPPI
 BOARD OF WATER COMMISSIONERS
 416 North State Street
 Jackson, Mississippi 39201

WATER WELL DRILLERS LOG

Clairborne
 H2003
 2-68


July 19 68 E. B. Jew Clairborne
 date well completed firm name county well located

LANDOWNER: <u>R. M. Jones</u> <u>Carleisle, Miss.</u> (mailing address)	description of formations encountered	from	to
	<u>Brown + White</u> <u>cl</u>	<u>0</u>	<u>13</u>
	<u>Sd + Gravel</u>	<u>13</u>	<u>20</u>
	<u>blue clay</u>	<u>20</u>	<u>50</u>
	<u>Sand</u>	<u>50</u>	<u>66</u>

WELL LOCATION:
 sec 27 T 12 N R 4 E
1 N. miles S of Carleisle, Miss
 (distance) (direction) (nearest town)

WELL PURPOSE: Home
 (home, irrigation, municipal, industrial)

- WELL COMPLETION DATA:
- (1) diameter (inches) 4 1/4
 - (2) total depth (feet) 66
 - (3) static water level (feet) 30 below above top of ground.
 - (4) casing Galv, 61
 (material) (depth)
 _____ if telescope see back.
 (size)
 - (5) screen 5, 61
 (length) (depth to top)
2, SS
 (size) (material)
 - (6) pump 1, 6
 (HP) (yield gpm)
Elec
 (type power)
 - (7) electric log No
 (yes or no)
None
 (organization running log)
 - (8) how well bottom plugged B.W. Value

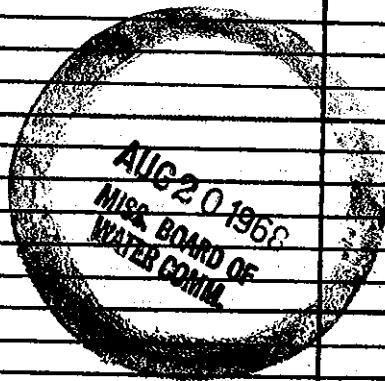

DRILLERS REMARKS: