

CLAIBORNE
K 14
10-3-67
GW 2840

MISSISSIPPI
BOARD OF WATER COMMISSIONERS
 416 North State Street
 Jackson, Mississippi 39201

CODED

WATER WELL DRILLERS LOG

10-3 date well completed 1967 *Layne-Central Co.* firm name *Claiborne* county well located

LANDOWNER:
Alcorn A&M College
Alcorn, Miss.
 (mailing address)

WELL LOCATION:
 sec 18 T 11N R 1E
 S W
 AT WATER TREATMENT PLANT
 (distance) miles (direction) of (nearest town)


description of formations encountered	from	to
<i>HARD Clay</i>	<i>0</i>	<i>70</i>
<i>Rock</i>	<i>70</i>	<i>73</i>
<i>Clay</i>	<i>73</i>	<i>103</i>
<i>Clay and sand</i>	<i>103</i>	<i>136</i>
<i>Sand and gravel</i>	<i>136</i>	<i>180</i>
<i>Sand and gravel</i>	<i>180</i>	<i>206</i>

WELL PURPOSE: *Domestic*
 (home, irrigation, municipal, industrial)

WELL COMPLETION DATA:

CODED

- (1) diameter (inches) 24"
- (2) total depth (feet) 214'9"
- (3) static water level (feet) _____ below
 top of ground. above
- (4) casing Steel 184'9"
 (material) (depth)
24" If telescope see back.
 (size)
- (5) screen 20' 184'9"
 (length) (depth to top)
16" Stainless Steel
 (size) (material)
- (6) pump 50 300
 (HP) (yield gpm)
Electric
 (type power)
- (7) electric log NO
 (yes or no)
 (organization running log) _____
- (8) how well bottom plugged _____

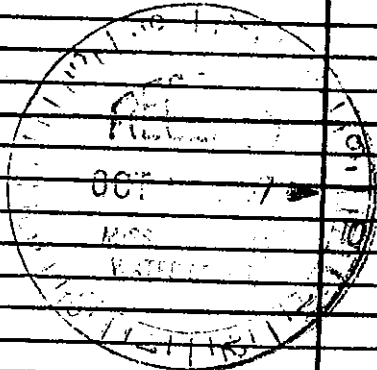

DRILLERS REMARKS: