State W	ell Report			
	art 1	For Office Use Only:		
County: Mississippi Departmen	t of Environmental Quality	Aquifer:		
Permit #: Office of Land a	nd Water Resources	Well #:K 60		
	lox 10631			
	IS 39289-0631 961-5210	L. S. Elevation:		
Duto drining compression in the second	4-6938 (fax)	E-log #:		
State Law requires that this report be prepared by the	driller in detail and filed w	vith the Department within		
30 days of completion of drilling of the well. Well Owner Information	Wel	I Location		
Owner Name JHW Land Co, LLC	LC Latitude: 31 . 53 . 38 " Longitude: 91 . 02			
Mailing Address: Charlie Franklin	Method of Lat/Long (circle o	ne): Conventional Survey,		
6163 Kay Brook Dr.	USGS quad, Hand-held	d GPS, Survey-grade GPS 1		
Byram MS 39272	1R 1/4 1R 1/4 Sec. 55			
$\frac{1}{1}$ City State Zip Code	Distance Direction	Nearest Town.		
Telephone No. (60) 720 - 8258				
Well				
Purpose of Well (circle one Home Industrial Public Supply Irrigation Fish Culture Other:				
Date well drilling started: $11 - 7 - 12$ Date well drilling completed: $11 - 8 - 12$				
If flowing, method of flow regulation: Valve Other (describe)				
Static Water Level:feet above of below (circle one) land surface Date measured:				
Method of Measurement (circle one) steel tape electric tape air line other:				
Hole depth: <u>250'</u> Well depth: <u>250'</u> Well grouted to a depth of <u>10</u> feet				
Type of grout (circle one): Cement Bentonite Mix				
Casing length: <u>230</u> feet Casing diameter: <u>4</u>		•		
Screen length: <u>20</u> feet Screen diameter: <u>4</u>				
Screen slot size: <u>1010</u> inches Setting depth: From <u>230</u> feet to <u>250</u> feet				
Type of completion (circle all applicable): Gravel packed Underreamed Telescoped Open hole Natural Development				
Other (describe):				
Top of lap pipe or reduction in casing:feet. If telescoped or more than one screen, describe on back of page				
Logs run (circle all applicable): No log run Electric Gamma Ra	y Density Sonic Neutron	Other:		
Name of organization running log(s):	accordance with all annlicah	le requirements of the Mississinni		
Department of Environmental Quality and/or the Mississippi D				
RAYBORN DRILLING, INC. 0-60				
Print Name of Water Well Contractor and License No.	Signature	of Water Well Contractor		
		DEC U 6 2012		
		RV- MUME		
		Care in Care in Care		

•


K60

If well telescopes please sketch below and show depths.



Description of Formations Encountered	From	To
CHALK	0	150
SAND STREAKS	150	160
CHALK	160	219
COARSE SAND	219	250

If more than one screen, show location of each on sketch

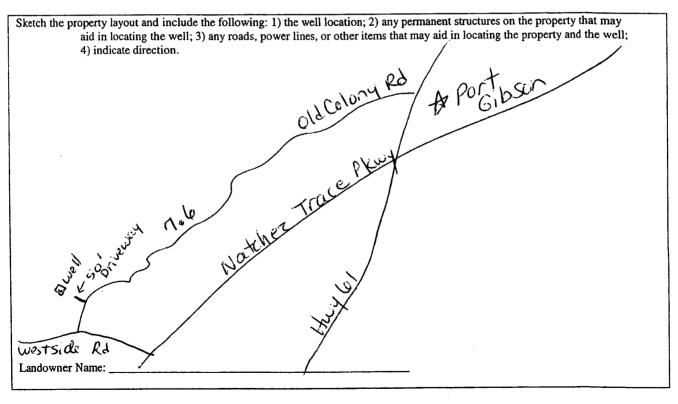

Signature of Water Well

RETAILE) DE LE ME

	LL REPORT		
County: <u>Clarborne</u> Permit #: <u>Permit #:</u> <u>Primp Installer's</u> Mississippi Department Office of Land au P.O. B Jackson, M (601)	rt 2 Completion Report of Environmental Quality and Water Resources ox 10631 S 39289-0631 061-5210	For Office Use Only:   Aquifer:   Well #:	
Date completed: $11^{\circ}O^{\circ}12^{\circ}$ (601)354	-6938 (fax)	Elevation:	
This report should be prepared by the pump installer in detail	and filed with the Departme	nt within 30 days of the	
installation of pump. Well Owner Information	We	Il Location	
Owner Name: JHW Land Co LLC	Latitude:	_ Longitude:	
Mailing Address: <u>90 Charlie Franklin</u>	Method of Lat/Long (circle of	one): Conventional Survey,	
6163 Kay Brook Dr	USGS quad, Han	and-held GPS, Survey-grade GPS	
Byram MS 39272	IR 1/4 IR 1/4 Sec. 5	Sec. 57 Twn 11 1N Rng 2E	
City State Zip Code	Distance Direction		
Telephone No. (601) 720-8258	8 Miles 5/SW of Port Gibson		
Ритр Туре	P	ower Type	
Circle one		Circle one	
Air Lift Jet Submersible	Diesel Engine Gasol	ine Engine Natural Gas	
Bucket Piston Turbine (	Electric Motor Hand	Tractor PTO	
Centrifugal Rotary Flowing Well	Windmill Other (specify):		
Other (specify):	Horse Power Rating of Motor:5		
Date Pump Installed: 11-8-12	Setting Depth:feet		
Rated Pump Capacity:	Number of Stages:	1	
Pump Test Data		feasuring Water Level Circle one	
Date Well Tested: 11-8-12		easuring Line ) Steel Tape	
Static Water Level (A): Feet Below Land Surface			
Pumping Water Level (B):Feet Below Land Surface	Other (specify):		
Drawdown [(B) – (A)]:Feet Below Land Surface	For flowing well, measured	shut in head:feet	
Test Pumping Rate:Gallons Per Minute	Well yielded 19	GPM with a drawdown of	
Duration of Pump Test (minimum 4 hours):hours	feet after	hours of pumping	
I HEREBY CERTIFY that the above statements are true to the best	of my knowledge.		
REVERSIN DRILLING, INC. 0-60 Print Name of Pump Installer and License No. (if applicable)	Signature of Pump	Installer	
		andar 1997年1月1日日本日本日本日本日本日本日本日本日本日本日本日本日本日本日本日本日本日本	

•