State W	ell Report	To Come Vie Only			
of Clairborne	art 1	For Office Use Only:			
Mississippi Departmen	of Environmental Quality	Aquifer:			
	nd Water Resources ox 10631	Well #:K61			
	S 39289-0631	L. S. Elevation:			
1 Date di lilile completed. 11 112 112 11	961-5210	E-log #:			
(601)354	1-6938 (fax)	E-log #.			
State Law requires that this report be prepared by the 30 days of completion of drilling of the well.					
Well Owner Information	Well Location				
Owner Name Ernest Posner		5" Longitude: 91 ° 6 · 4 6"			
Mailing Address: 122 White Oak Lane	Method of Lat/Long (circle one): Conventional Survey,				
	USGS quad, Hand-held GPS, Survey-grade GPS				
Modison ville, LA 70447 City State Zip Code		Twn IIN Rng IE			
Telephone No. 504) 491 - 4263	Distance Direction Nearest Town 2.8 Miles E of ALCORN				
Well	Data Data				
Purpose of Well (circle one) Home Industrial Public Supply	Irrigation Fish Culture	Other:			
Date well drilling started: 11-4-12 Date	well drilling completed:	11-10-12			
If flowing, method of flow regulation: Valve Other (describe)				
Static Water Level: 155 feet above or below (circle one)	land surface Date measured	: 11-10-12			
Method of Measurement (circle one) steel tape electric tap		10			
Hole depth: 190 / Well depth: 190 /	_ Well grouted to a depth of	<u>O</u> feet			
Type of grout (circle one): Cement Bentonite Mix		DVC			
Casing length: 170 feet Casing diameter: 4		PVC			
Screen length: 20 feet Screen diameter: 4 inches Type of screen: PVC					
Screen slot size: 1010 inches Setting depth: From 170 feet to 190 feet					
Type of completion (circle all applicable): Gravel packed Und	erreamed Telescoped Op	en hole Natural Development			
Other (describe):					
Top of lap pipe or reduction in casing:feet. If					
Logs run (circle all applicable) No log run Electric Gamma Ra	y Density Sonic Neutron	Other:			
Name of organization running log(s): I certify that the well was drilled, constructed, and completed in	accordance with all annical	le requirements of the Mississinni			
I certify that the well was drilled, constructed, and completed in	accuruance with an applicat	one and state laws.			
Department of Environmental Quality and/or the Mississippi D	ерагивен от глеани гедини	JES GIRL STATE IN 11 St			
RAYBORN DRILLING, INC.					
Print Name of Water Well Contractor and License No.	Signature	e of Water Well Contractor			

RECEIVED DEC U 5 2012

STATE WELL REPORT

Part 2

Pump Installer's Completion Report Mississippi Department of Environmental Quality Office of Land and Water Resources
P.O. Box 10631 Permit #:

For Office Use Only:
Aquifer:
Well #:K61
Elevation:

Driller Gary Kayborn Date completed: 11-10-12	Jackson, MS (601)96	061-5210			K61	
This report should be prepared by the purn installation of pump.	np installer in detail a	and filed with the D			of the	
Well Owner Information		Well Location				
Owner Name: ERNEST POSNE	<u>r</u> 1	Latitude:Longitude:				
Mailing Address: 122 White O	ak Lane In	Method of Lat/Long (circle one): Conventional Survey,				
		USGS qu	ad, Hand-h	eld GPS, Surv	ey-grade GPS	
Madisonville LA		1R 14 1R 14 Sec 54 Twn 11N Rng 1E			Rng IE	
City State	Zip Code	Distance Di	rection	Nearest Tow	'n	
Telephone No. (504) 491 - 4263	3	2.8 Miles E	<u></u> of _	Alcom	<u> </u>	
Pump Type			Powe	er Type		
Circle one	·		Circ	le one		
Air Lift Jet Sub	omersible	Diesel Engine	Gasoline	Engine	Natural Gas	
Bucket Piston Tur	bine	Electric Motor	Hand		Tractor PTO	
Centrifugal Rotary Flo		Windmill		pecify):		
Other (specify):		Horse Power Rating	of Motor: _	1 - H	IP	
Date Pump Installed:		Setting Depth:			_feet	
Rated Pump Capacity:Galle	ons Per Minute	Number of Stages: _	14		-	
Pump Test Data		Metl		suring Water I	.evel	
Date Well Tested:			Circ	cle one		
Static Water Level (A): 155 Feet Belo	w Land Surface	_	ectric Measu	ring Line	Steel Tape	
Pumping Water Level (B):Feet Below	w Land Surface	Other (specify):				
Drawdown [(B) - (A)]:Feet Belo	w Land Surface	For flowing well, m	easured shu	t in head:	feet	
Test Pumping Rate: Gall	ons Per Minute	Well yielded CPM with a drawdown of				
Duration of Pump Test (minimum 4 hours):	hours	f	eet after	hc	ours of pumping	
I HEREBY CERTIFY that the above statements RAYBORN DRILLING, INC. Print Name of Pump Installer and License No. (i	<u>)-60</u>		of Pump Ins	talld	2 m 2 m 1 m	

Signature of Pump Installer

DEC U = 2012


de la completa del completa de la completa del completa de la completa del completa del completa del completa de la completa del complet

and the second of the second o

Ground Level

Description of Formations Encountered	FIUIII	10
Allas	0	155
CHALK		122
		1 1
SAND	156	190
SAND	175	1770
		1 1
		+
		ļ .
		
		+
		
		┼
	1	
		+
		+-
		
	1	
		+-
		+
1		

If more than one screen, show location of each on sketch

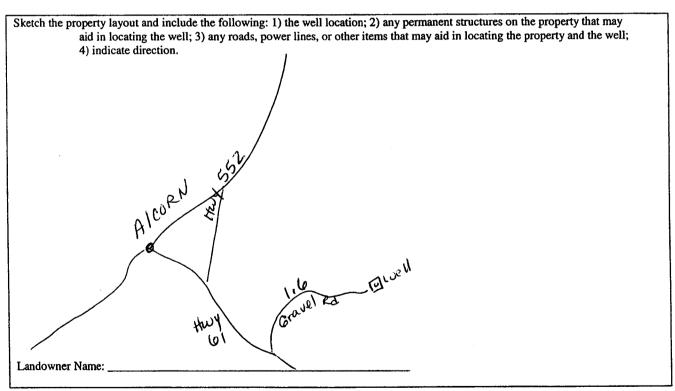

Signature of Water Well Contravor

OFC US 2012