

State Well Report

Part 1

Mississippi Department of Environmental Quality
Office of Land and Water Resources
P.O. Box 10631
Jackson, MS 39289-0631
(601)961-5210
(601)354-6938 (fax)

For Office Use Only:

Aquifer: _____
Well #: K62
L. S. Elevation: _____
E-log #: _____

County: Clairborne
Permit #: _____
Driller: Gary Rayborn
Date drilling completed: 12-12-12

State Law requires that this report be prepared by the driller in detail and filed with the Department within 30 days of completion of drilling of the well.

Well Owner Information	Well Location
Owner Name: <u>John Sequest</u>	Latitude: <u>31° 55' 14"</u> Longitude: <u>91° 00' 17"</u>
Mailing Address: <u>P.O. Box 14</u>	Method of Lat/Long (circle one): Conventional Survey,
<u>Port Gibson MS 39150</u>	USGS quad, Hand-held GPS, Survey-grade GPS
City State Zip Code	<u>1R ¼ 1R ¼ Sec 29 Twn 11N Rng 2E</u>
Telephone No. () _____	Distance Direction Nearest Town <u>6.2</u> Miles <u>S/SW</u> of <u>Port Gibson</u>

Well Data

Purpose of Well (circle one) Home Industrial Public Supply Irrigation Fish Culture Other: _____
Date well drilling started: 12/12/12 Date well drilling completed: 12/12/12
If flowing, method of flow regulation: Valve _____ Other (describe) _____
Static Water Level: 100 feet above or below (circle one) land surface Date measured: 12/12/12
Method of Measurement (circle one) steel tape electric tape air line other: _____
Hole depth: 180' Well depth: 180' Well grouted to a depth of 10 feet
Type of grout (circle one): Cement Bentonite Mix
Casing length: 160 feet Casing diameter: 4" inches Type of casing: PVC
Screen length: 20 feet Screen diameter: 4" inches Type of screen: PVC
Screen slot size: .010 inches Setting depth: From 160 feet to 180 feet
Type of completion (circle all applicable): Gravel packed Underreamed Telescoped Open hole Natural Development
Other (describe): _____
Top of lap pipe or reduction in casing: _____ feet. If telescoped or more than one screen, describe on back of page
Logs run (circle all applicable): No log run Electric Gamma Ray Density Sonic Neutron Other: _____
Name of organization running log(s): _____

I certify that the well was drilled, constructed, and completed in accordance with all applicable requirements of the Mississippi Department of Environmental Quality and/or the Mississippi Department of Health regulations and state laws.

Rayborn Drilling Inc. 060
Print Name of Water Well Contractor and License No.

Signature of Water Well Contractor

RECEIVED

JAN 03 2013

BY: OLWR

STATE WELL REPORT

Part 2

Pump Installer's Completion Report
Mississippi Department of Environmental Quality
Office of Land and Water Resources
P.O. Box 10631
Jackson, MS 39289-0631
(601)961-5210
(601)354-6938 (fax)

For Office Use Only:

Aquifer: _____

Well #: K62

Elevation: _____

County: Claiborne
Permit #: _____
Driller: Gary Rayborn
Date completed: 12-12-12

This report should be prepared by the pump installer in detail and filed with the Department within 30 days of the installation of pump.

Well Owner Information	Well Location
Owner Name: <u>John Segrest</u>	Latitude: _____ Longitude: _____
Mailing Address: <u>P.O. Box 14</u>	Method of Lat/Long (circle one): Conventional Survey, USGS quad, Hand-held GPS, Survey-grade GPS
<u>P. Gibson MS 39150</u> City State Zip Code	<u>1R 1/4 1R 1/4 Sec 29 Twn 11N Rng 2E</u>
Telephone No. (____) _____	Distance Direction Nearest Town <u>6.2 Miles S/SW of Port Gibson</u>

Pump Type Circle one	Power Type Circle one
Air Lift Jet <input type="radio"/> <u>Submersible</u>	Diesel Engine Gasoline Engine Natural Gas
Bucket Piston <input type="radio"/> Turbine <input type="radio"/>	<u>Electric Motor</u> Hand Tractor PTO
Centrifugal Rotary <input type="radio"/> Flowing Well <input type="radio"/>	Windmill Other (specify): _____
Other (specify): _____	Horse Power Rating of Motor: <u>2 HP</u>
Date Pump Installed: <u>12/12/12</u>	Setting Depth: <u>130</u> feet
Rated Pump Capacity: <u>20</u> Gallons Per Minute	Number of Stages: <u>11</u>

Pump Test Data	Method of Measuring Water Level Circle one
Date Well Tested: <u>12/12/12</u>	Air Line <input type="radio"/> <u>Electric Measuring Line</u> Steel Tape <input type="radio"/>
Static Water Level (A): <u>100</u> Feet Below Land Surface	Other (specify): _____
Pumping Water Level (B): _____ Feet Below Land Surface	For flowing well, measured shut in head: _____ feet
Drawdown [(B) - (A)]: _____ Feet Below Land Surface	Well yielded <u>20</u> GPM with a drawdown of _____ feet after _____ hours of pumping
Test Pumping Rate: <u>20</u> Gallons Per Minute	
Duration of Pump Test (minimum 4 hours): _____ hours	

I HEREBY CERTIFY that the above statements are true to the best of my knowledge.

Rayborn Drilling Inc 0-60
Print Name of Pump Installer and License No. (if applicable)

[Signature]
Signature of Pump Installer

RECEIVED
JAN 03 2013
BY: OLWR


If well telescopes please sketch below and show depths.

Ground Level

Description of Formations Encountered	From	To
Clialk	0	100
Fine Sand	100	140
Coarse Sand	140	180

If more than one screen, show location of each on sketch

Sketch the property layout and include the following: 1) the well location; 2) any permanent structures on the property that may aid in locating the well; 3) any roads, power lines, or other items that may aid in locating the property and the well; 4) indicate direction.

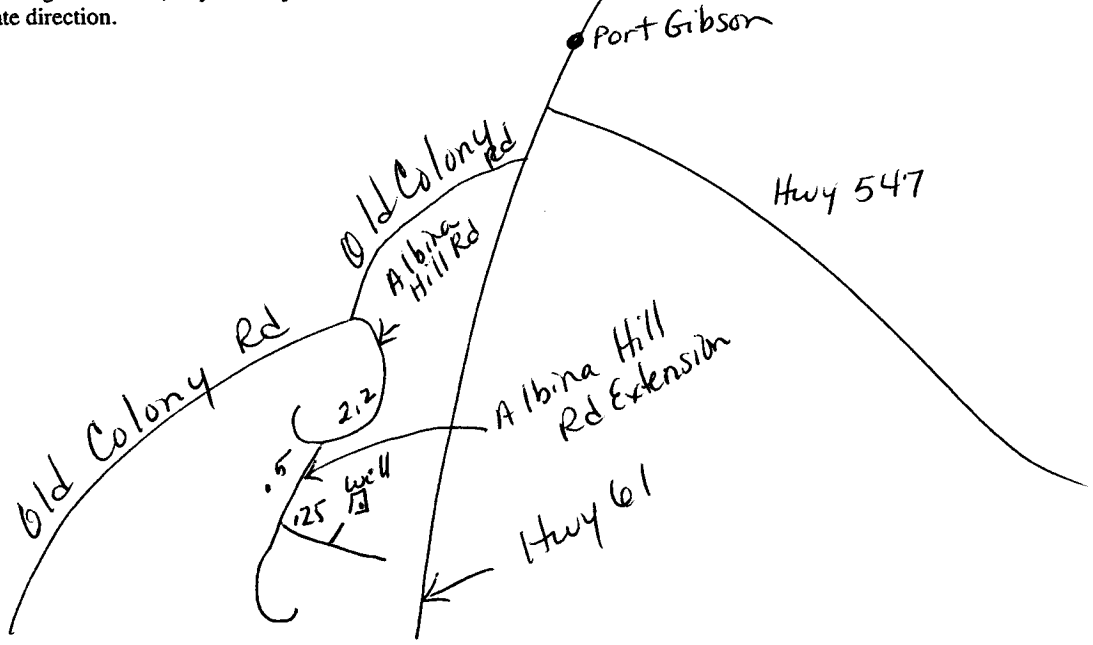

Landowner Name: _____

Signature of Water Well Contractor

RECEIVED
JAN 02 2013
BY: OLWR