

Claiborne

MISSISSIPPI BOARD OF WATER COMMISSIONERS

K 9000

8-1-66

WATER WELL DRILLERS LOG

Date: Aug 1, 1966, Driller: E B Fore County: Claiborne

(1) Owner of Land: Silks Hunting Club
 (Name)
 Port Gibson, Miss
 (Address)

(2) Location: 1/4, 1/4, Sect 59 T11 R1 E
 6 miles West of Lumberton
 (distance) (direction) (Nearest Town)

(3) Topography: Hilly
 (Hilly) (Flat) (Level)

(4) Purpose of Well: Hunting Club
 (Domestic Irrigation
 Municipal, Industrial, Other)

Description & Color of Materials Sand, Clay, Red Clay, Shell, etc.	Thick- ness Feet	Depth Feet
Brown Silty Clay	0	50
Gray & Blue Clay	50	95
Blue & White Silty Cl	95	115
Sd	115	120
Blue Cl & Sd Strakes	120	283
Sand -	283	298


Information upon completion of well:

- (1) Diameter 4 1/2 inches.
- (2) Total Depth 298 feet.
- (3) Water Level 179 feet below top of ground.
- (4) Cased to 285, Size 2'
- (5) Screen: Size 07, Length 10'
- (6) Were any formations sealed against pollution?
 _____ yes, _____ no.

If YES depth of formation _____

Why _____

Drillers Remarks: _____

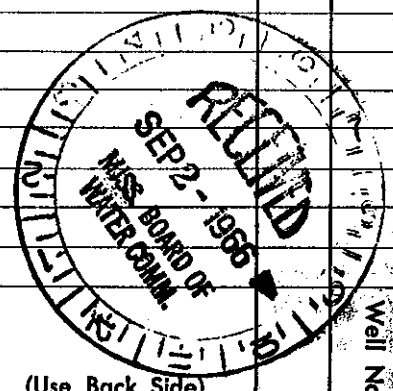

Well No.

(Use Back Side)